Clermont Bldg 1 Sub-Basement

LEGEND

SUMP PITS - Ground Water

STORM Water Pit

Pumps in Pits Need Electricty
without Power, Pits will Overflow

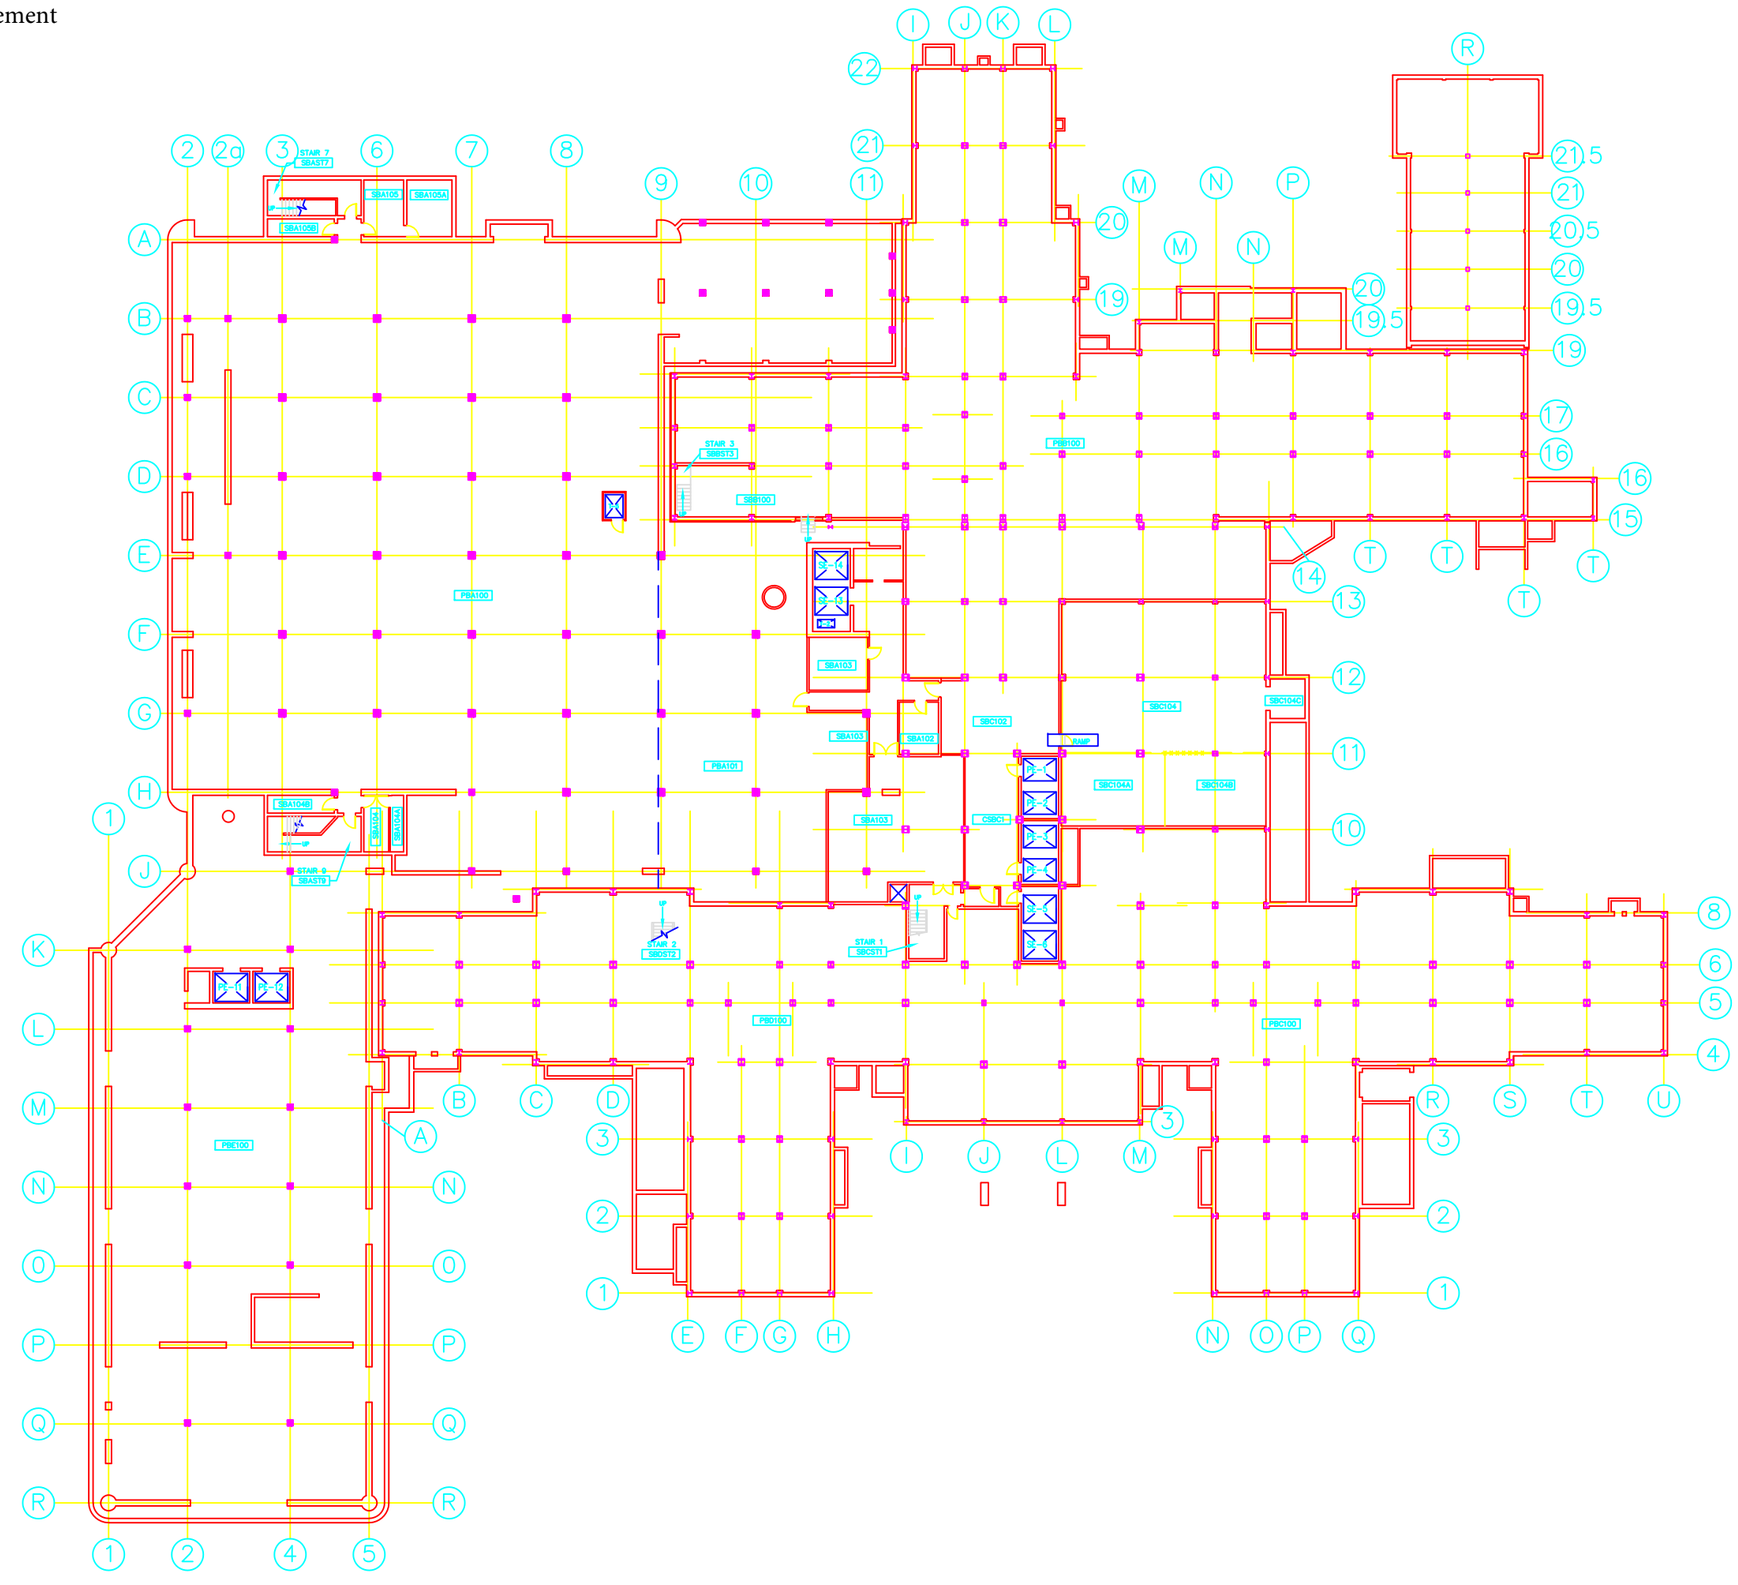

GENERAL NOTES:
1- SCALED DIMENSIONS & ARCHITECTURAL FEATURES MAY NOT BE CORRECT
2- CONTRACTORS & A/E's ARE TO FIELD VERIFY ALL DIMENSIONS.

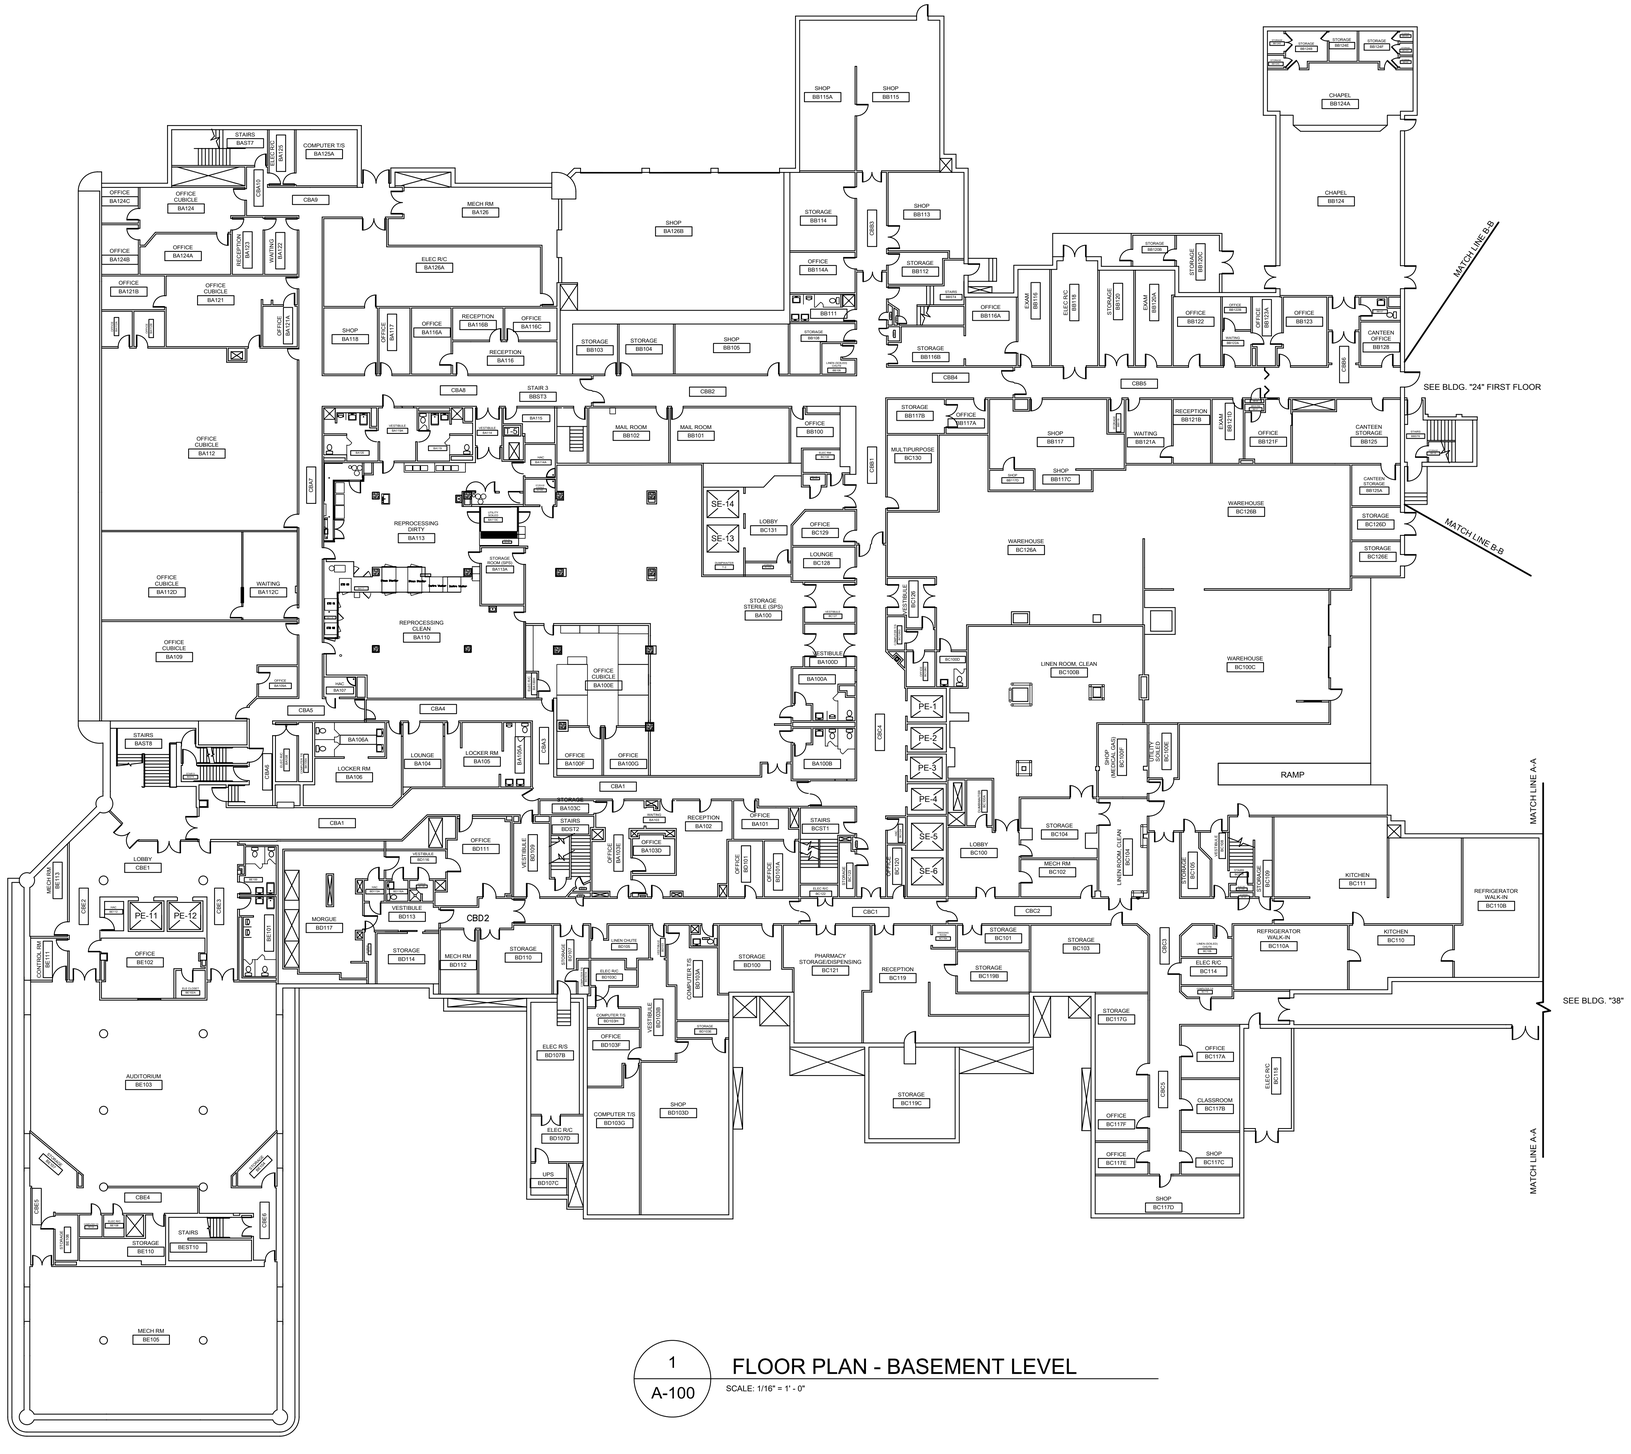

1
A-100

FLOOR PLAN - BASEMENT LEVEL

SCALE: 1/16" = 1' - 0"

PLAN NORTH

Revisions:	Date:

CONSULTANT
engineering discipline:

ARCHITECT/ENGINEER OF RECORD
A/E:

STAMP

Office of Construction and Facilities Management

VA U.S. Department of Veterans Affairs

Drawing Title: FLOOR PLAN BASEMENT LEVEL	Phase: AS-BUILT	Project Title: RECORD DRAWING FLOOR PLANS	Project Number
Approved: Project Director	DEPARTMENT OF VETERANS AFFAIRS MEDICAL CENTER	Location: 1055 Clermont St, Denver CO 80220	Building Number: Building 1
		Issue Date: 28 JUN 2017 / Checked: M.K. / Drawn: J.C.	Drawing Number: A-100

VA FORM 08 - 6231

S:\ENG All Shares\FINDC\DWG\BUILDING\SB1\B1 AS-BUILT COMPOSITE\5A-XXX_001_A100_20170629.dwg 6-29-19 11:14:51 AM VHADENKA4C

SCALE: 1:112" = 1'-0" SCALE: 1" = 1'-0" SCALE: 3/4" = 1'-0" SCALE: 1/2" = 1'-0" SCALE: 3/8" = 1'-0" SCALE: 1/4" = 1'-0" SCALE: 1/8" = 1'-0" SCALE: 1/16" = 1'-0"

6/14/2019 12:39:03 PM

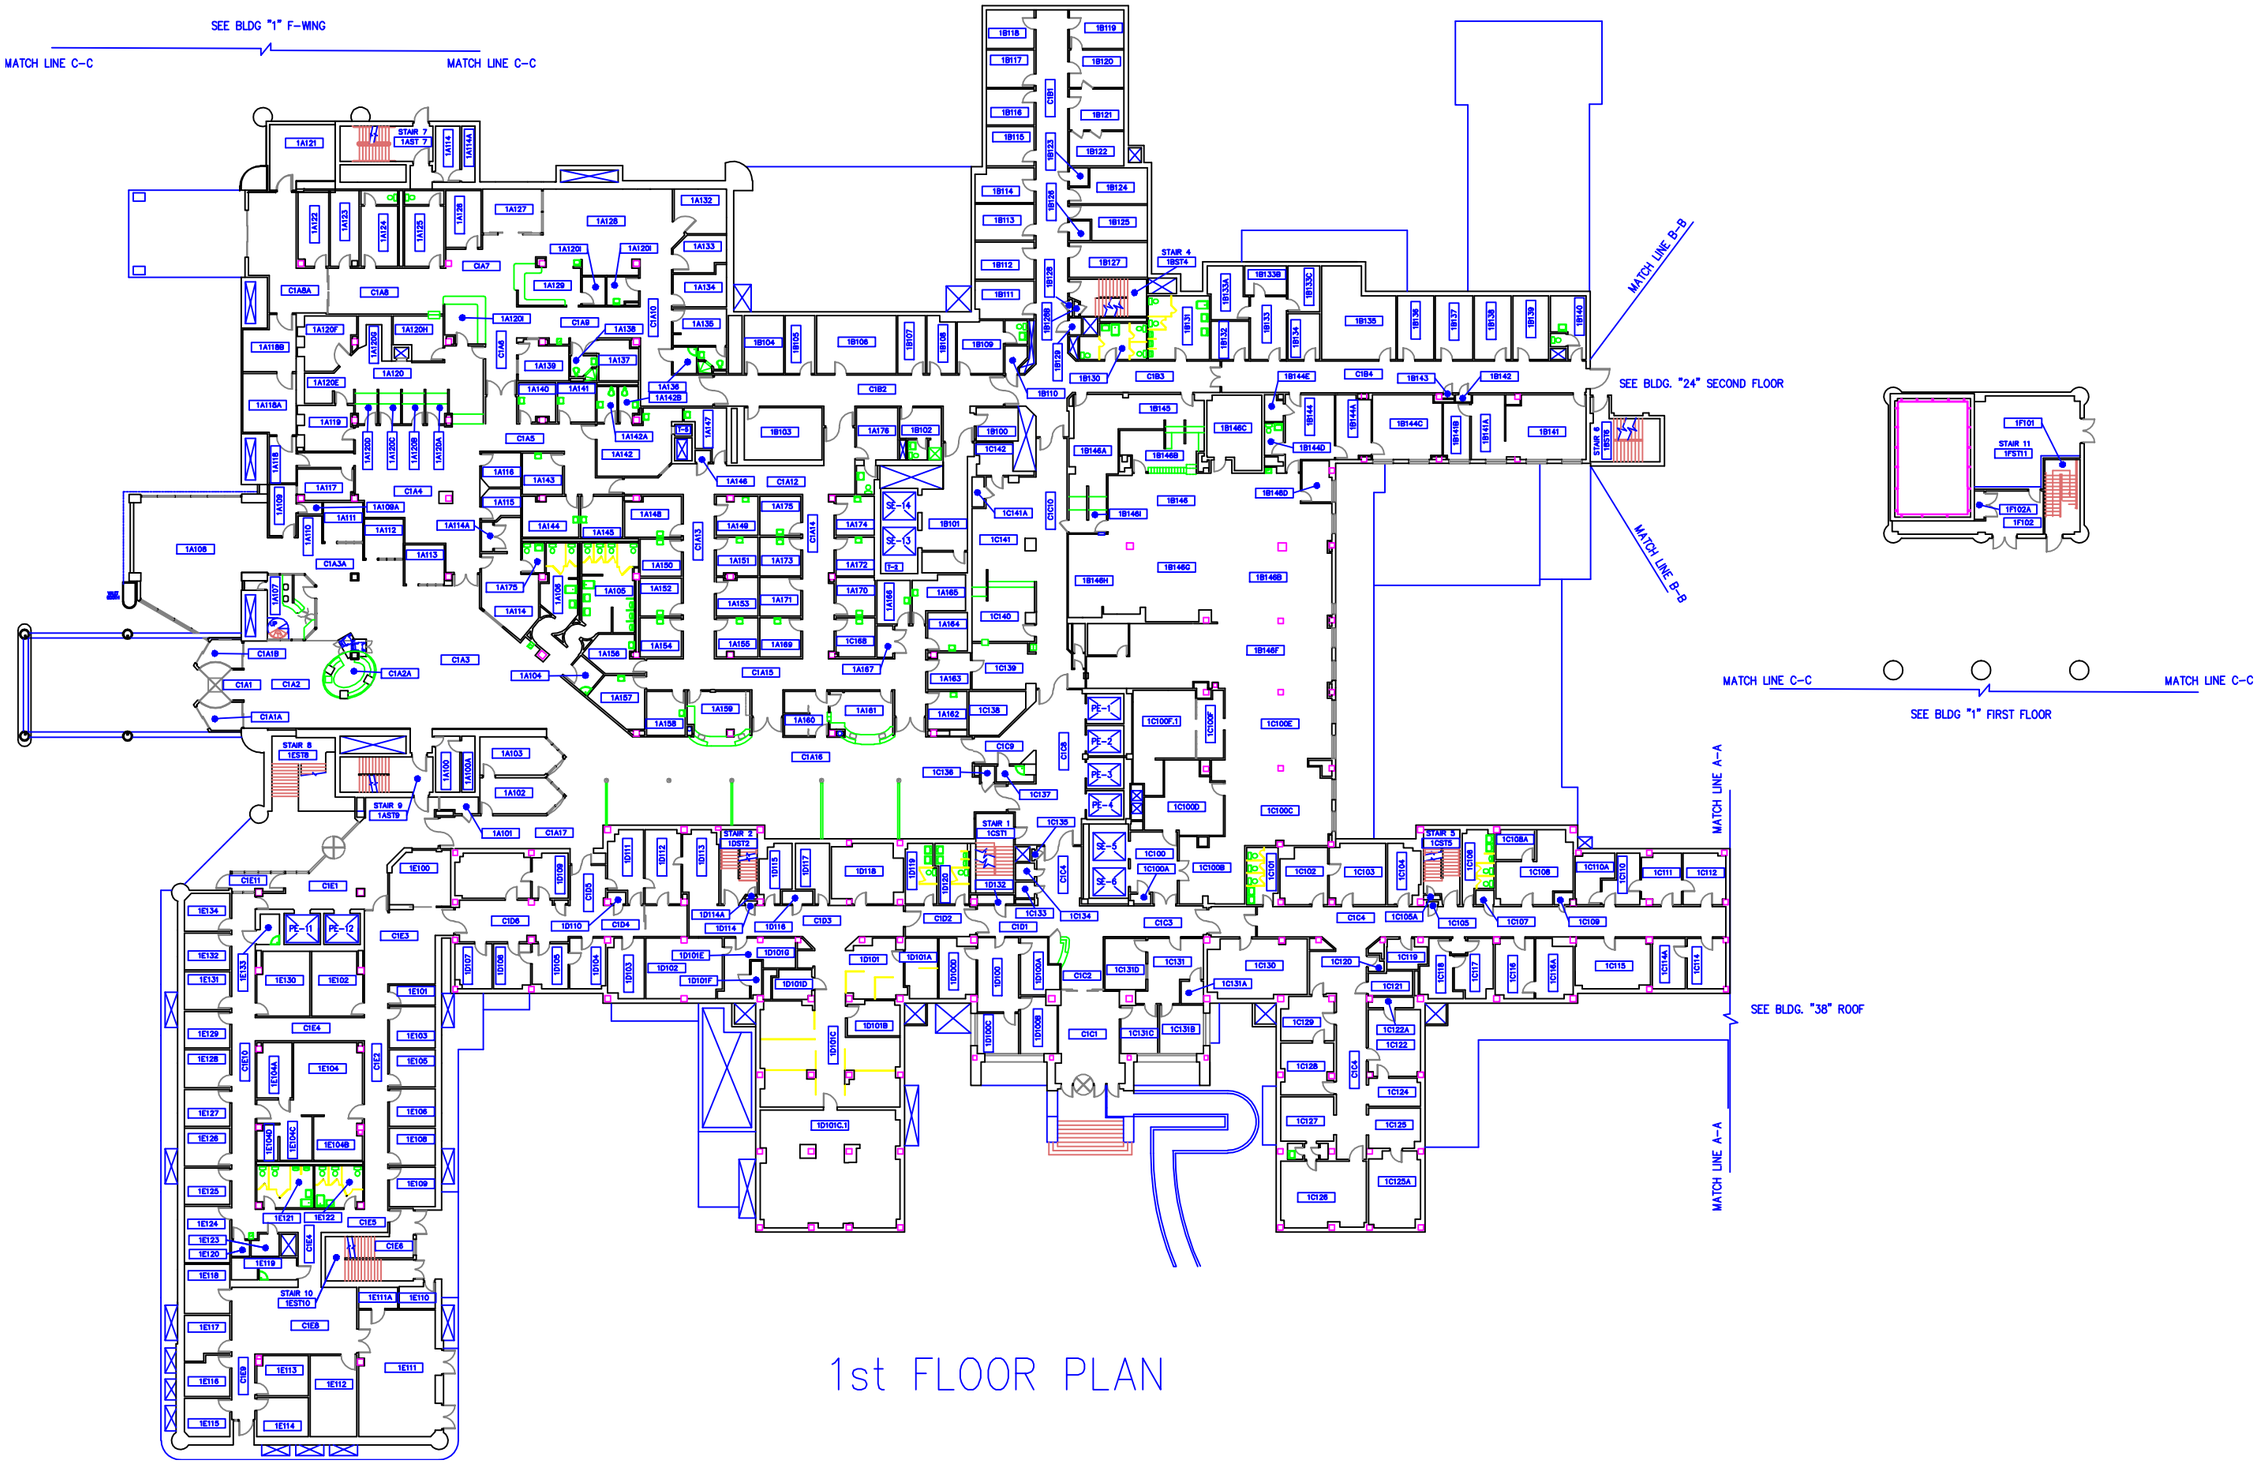

1st FLOOR PLAN

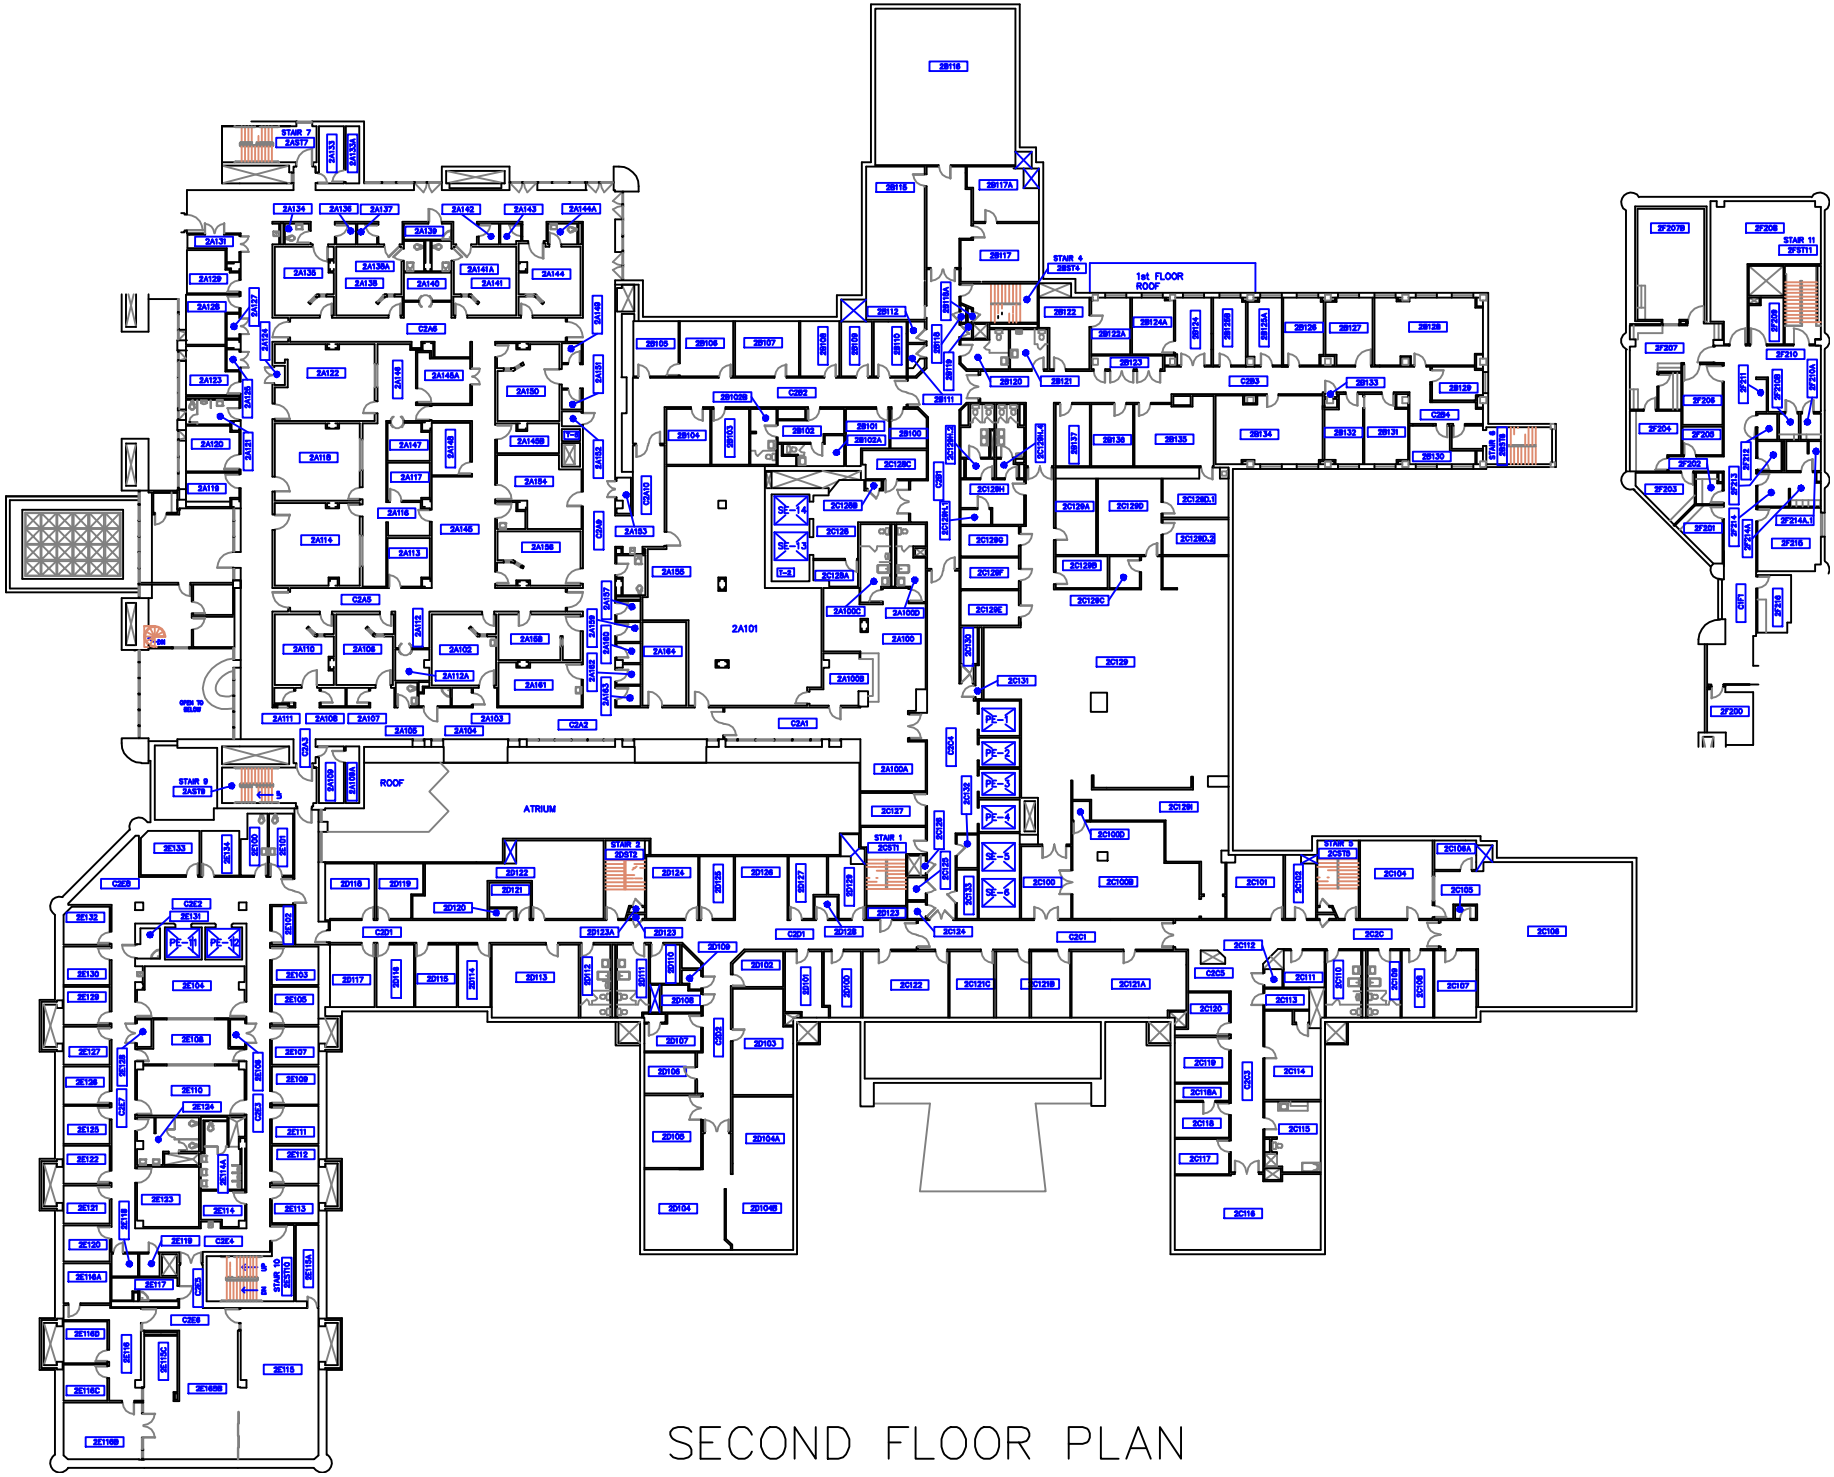

SECOND FLOOR PLAN

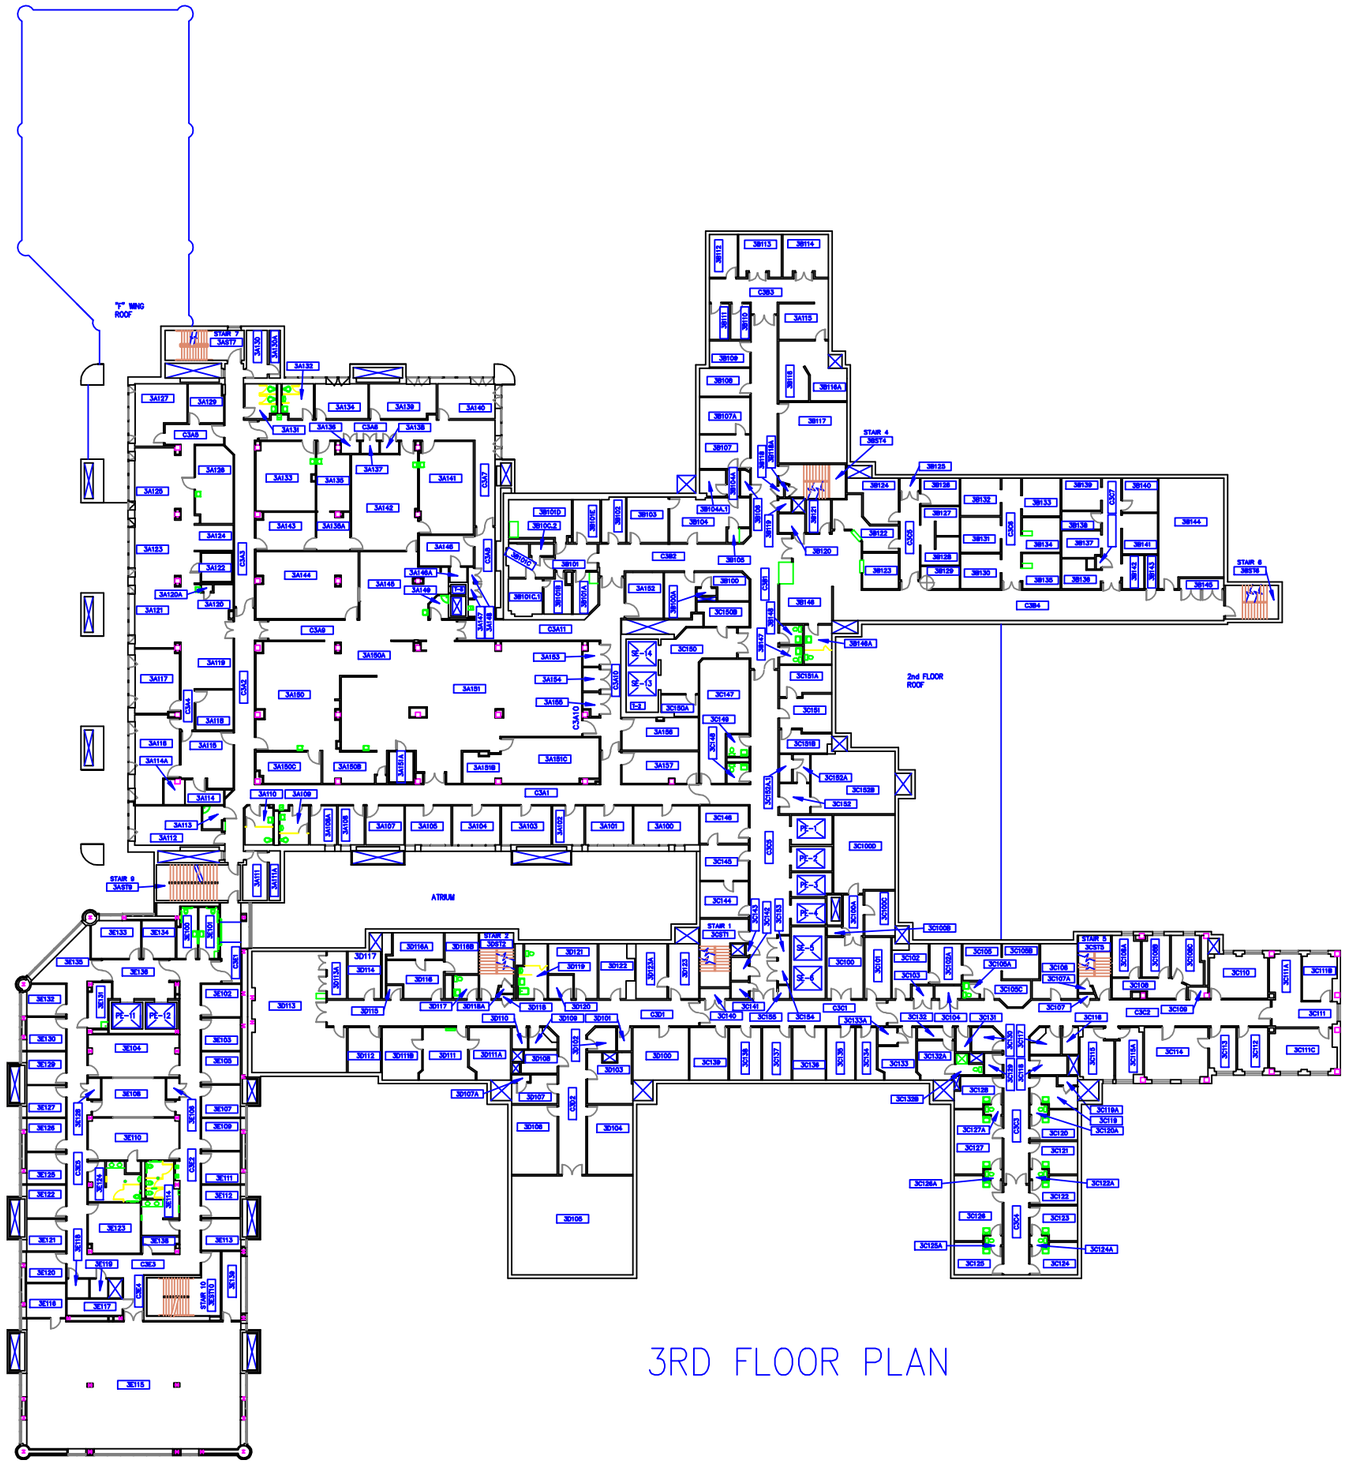

3RD FLOOR PLAN

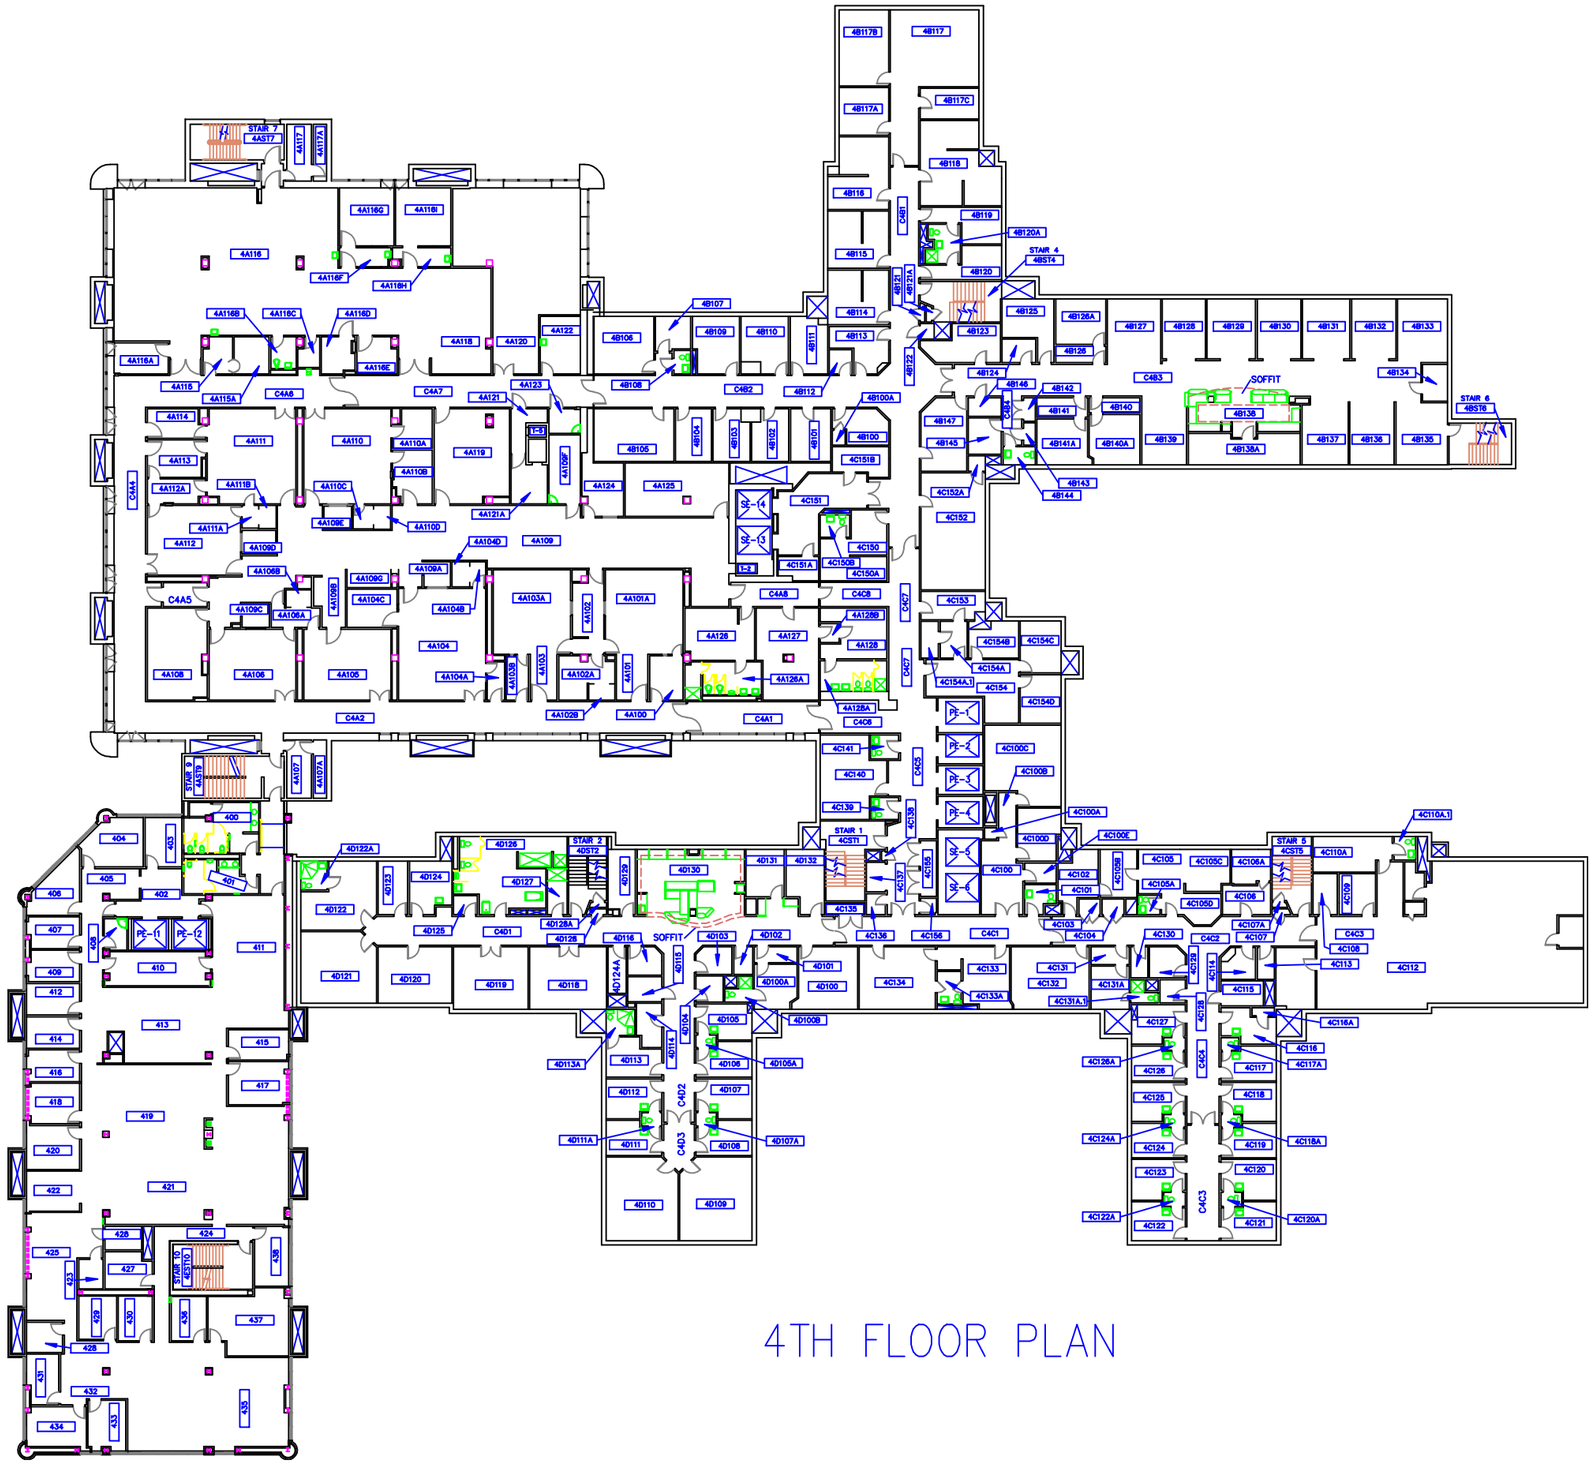

4TH FLOOR PLAN

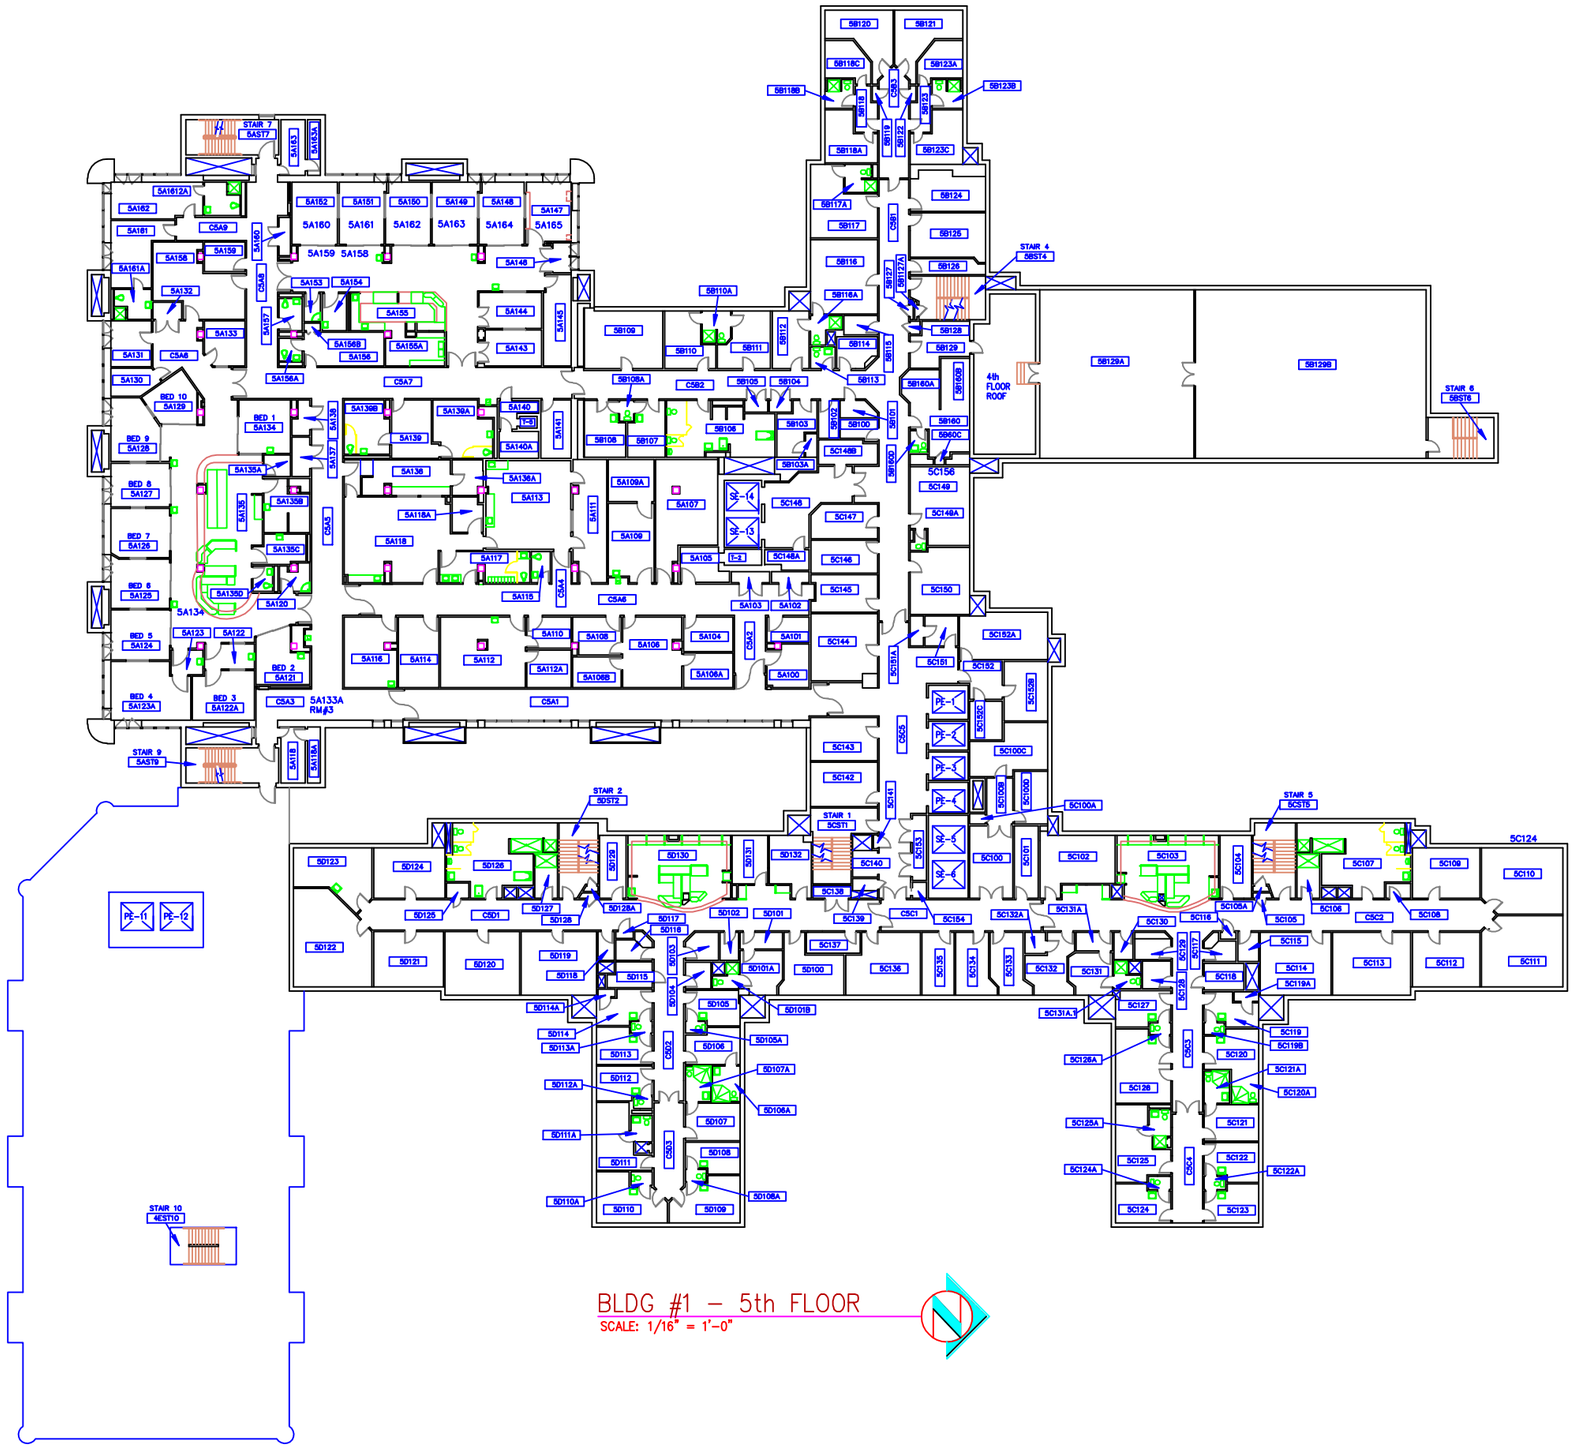

BLDG #1 – 5th FLOOR

SCALE: 1/16" = 1'-0"

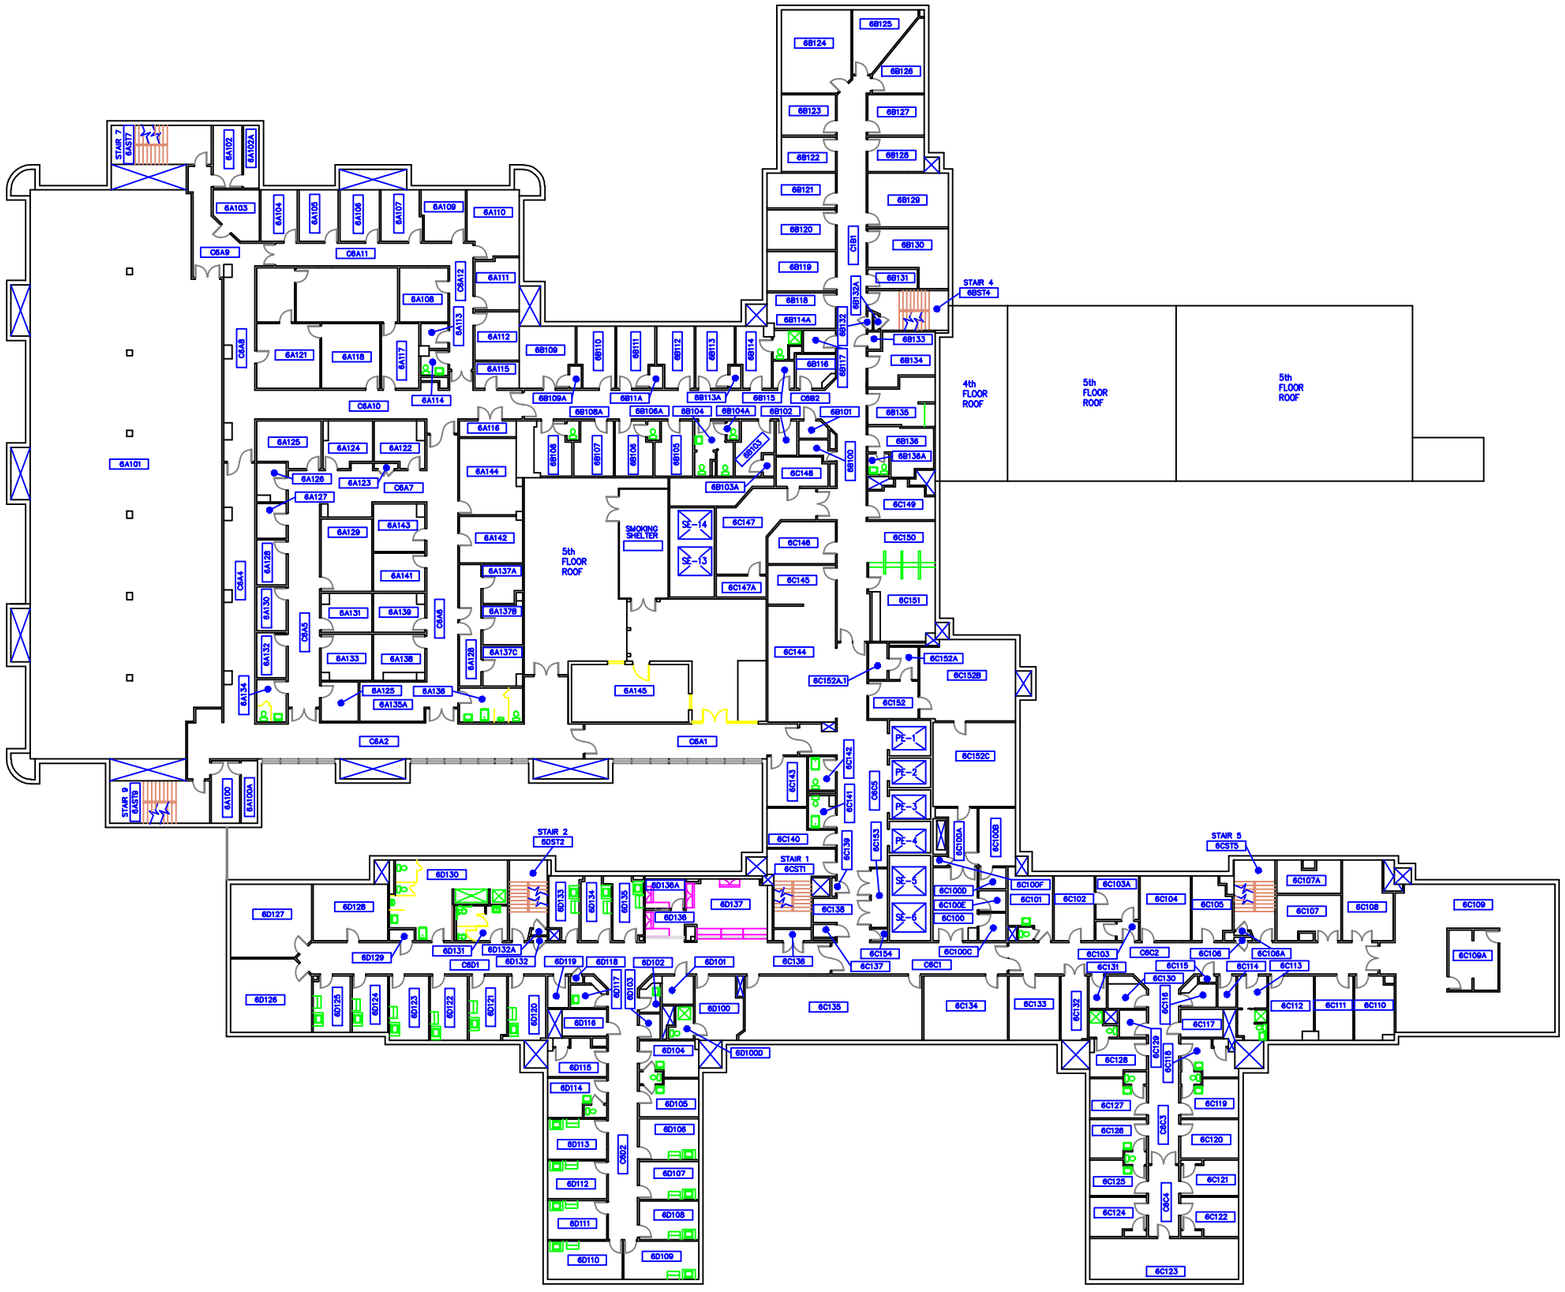

BLDG #1 – 6th FLOOR

SCALE: 1/16" = 1'-0"

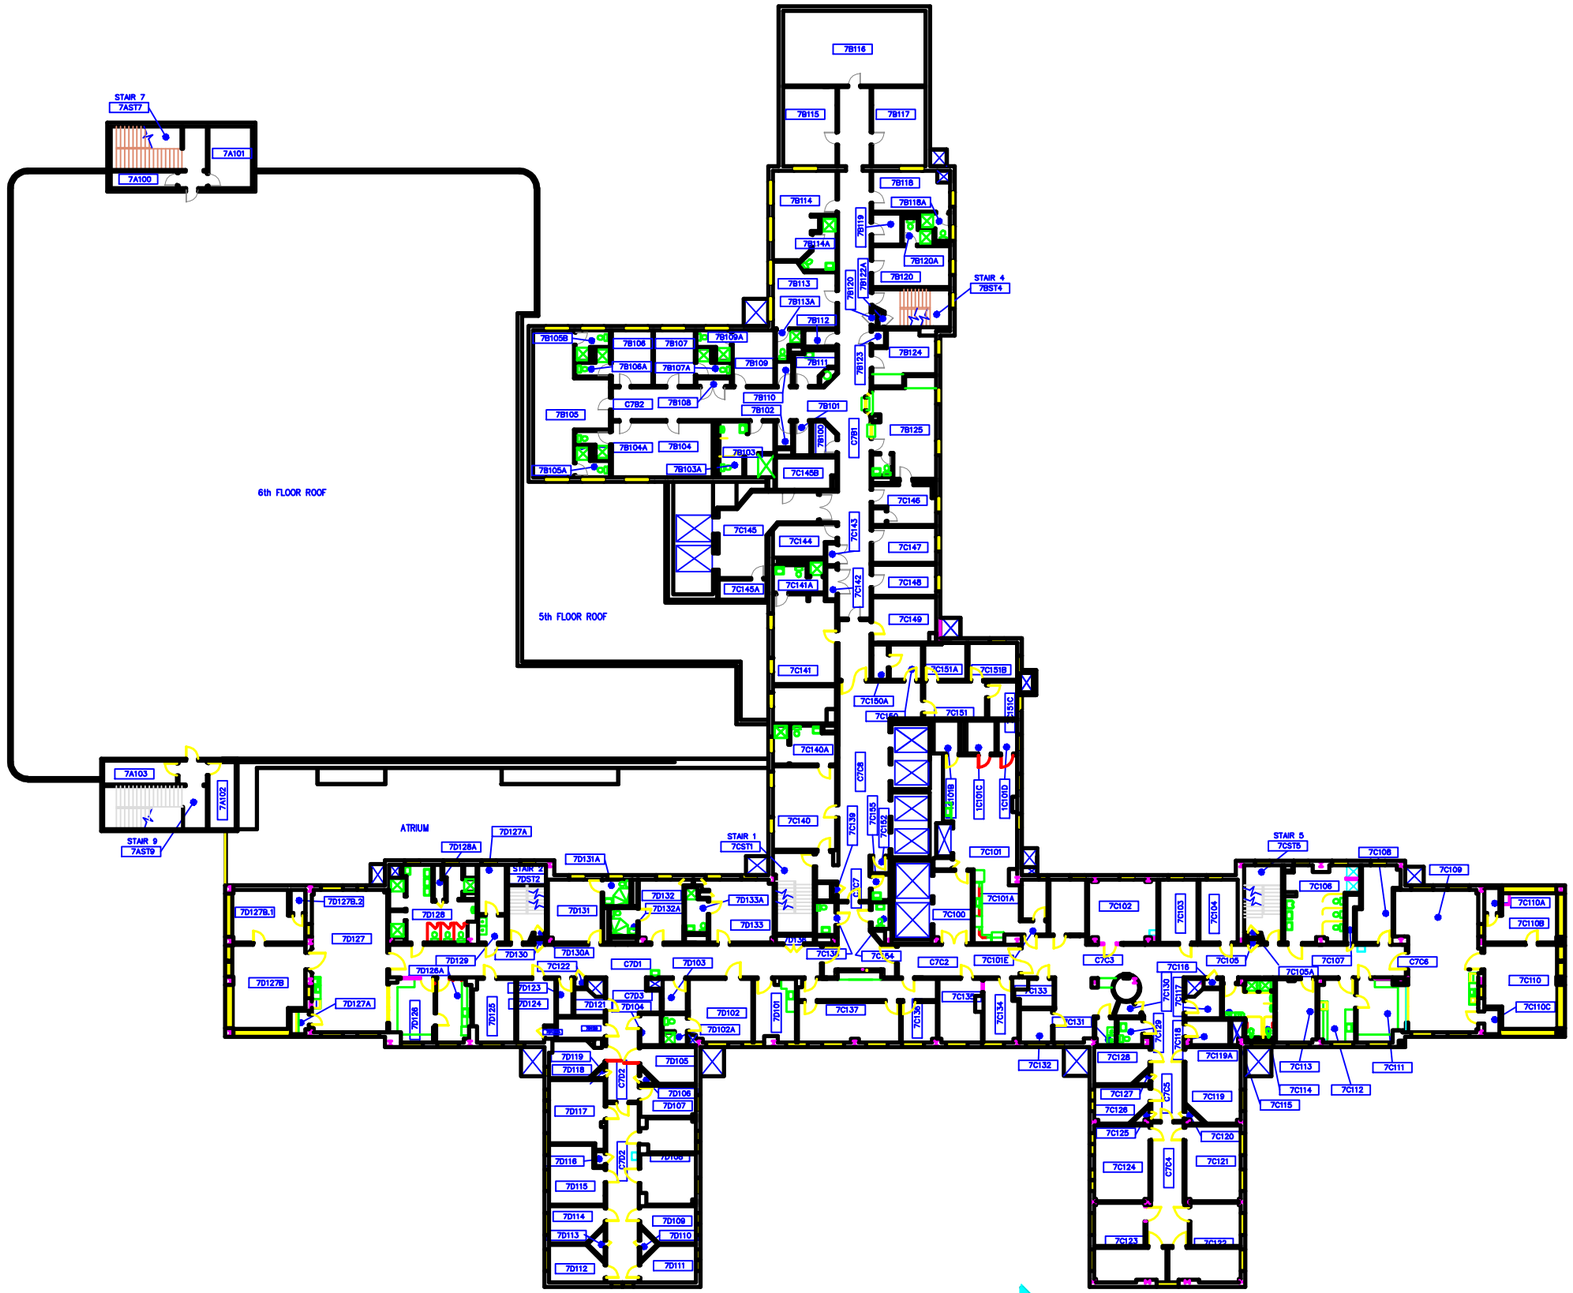

BLDG #1 – 7th FLOOR

SCALE: 1/16" = 1'-0"

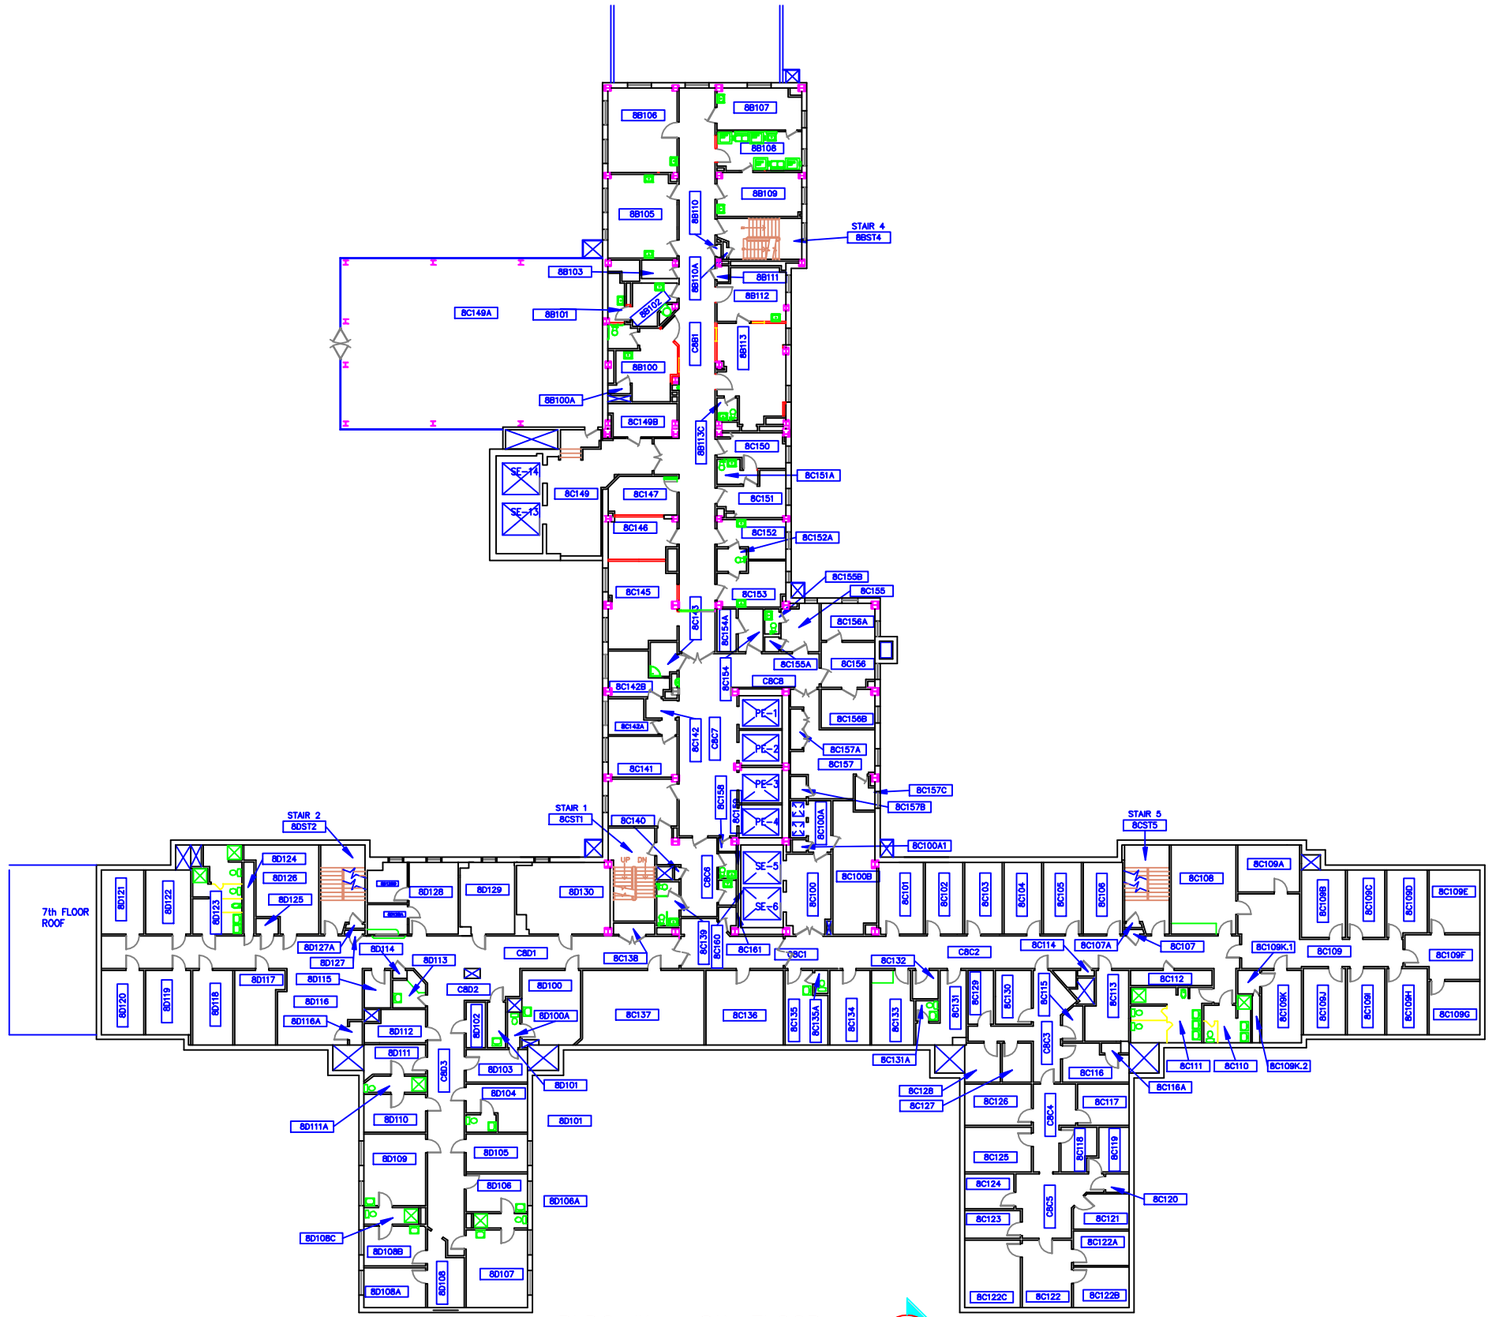

BLDG #1 – 8th FLOOR

SCALE: 1/16" = 1'-0"

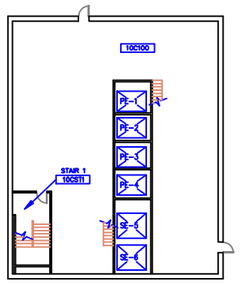

BLDG #1 – 10th FLOOR
SCALE: 1/16" = 1'-0"

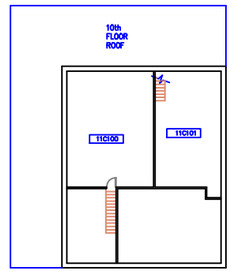

BLDG #1 – 11th FLOOR
SCALE: 1/16" = 1'-0"

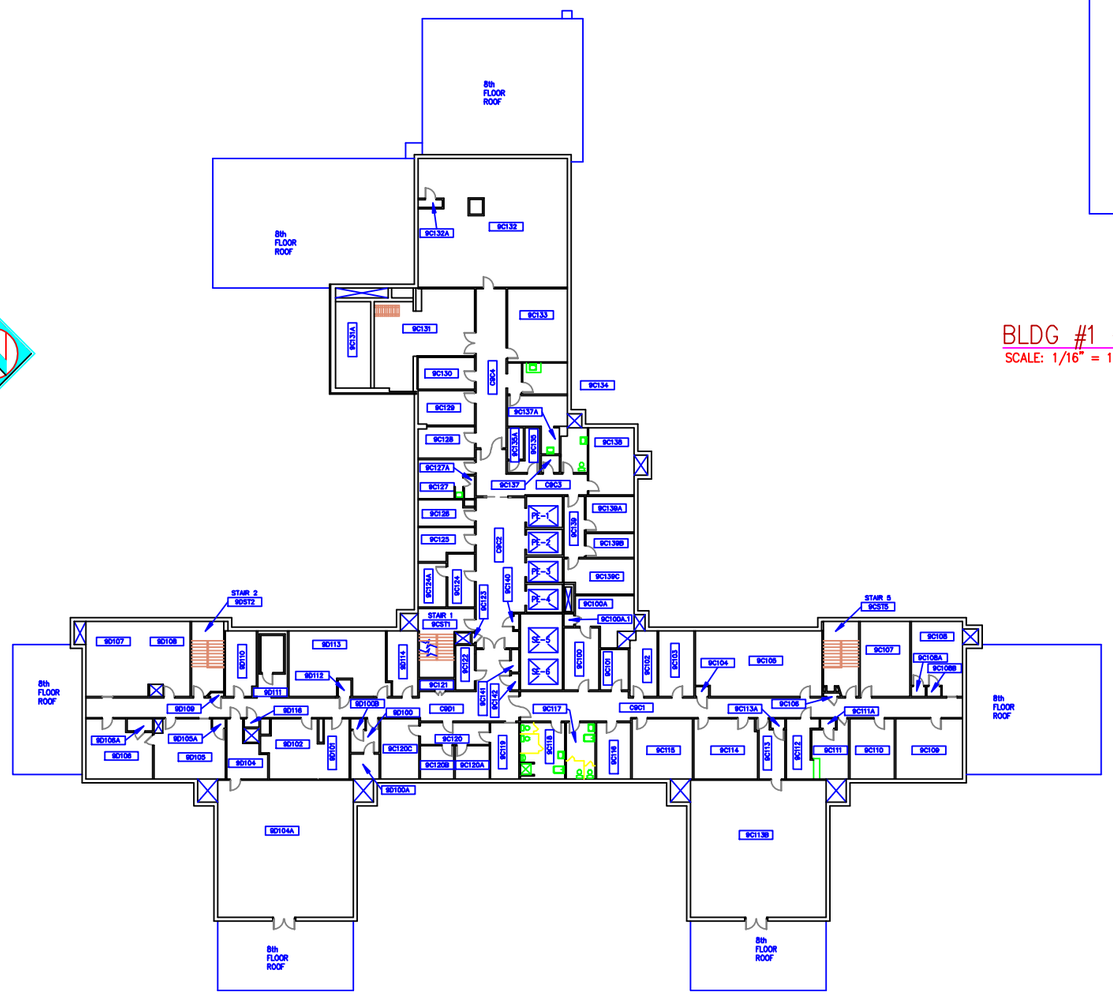

BLDG #1 – 9th FLOOR
SCALE: 1/16" = 1'-0"

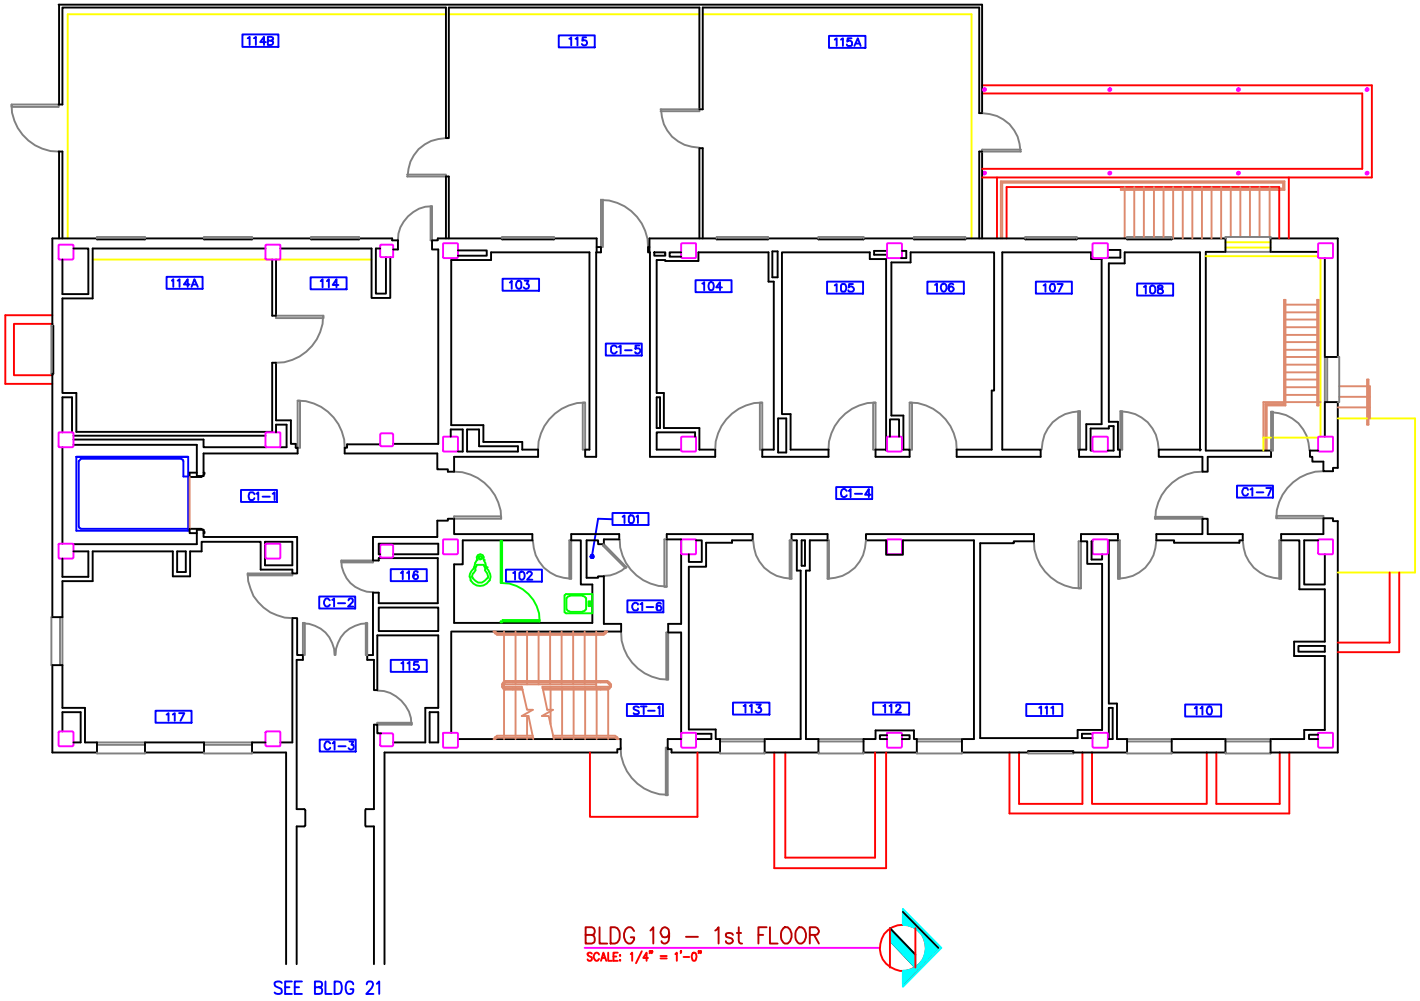

BLDG 19 – 1st FLOOR

SCALE: 1/4" = 1'-0"

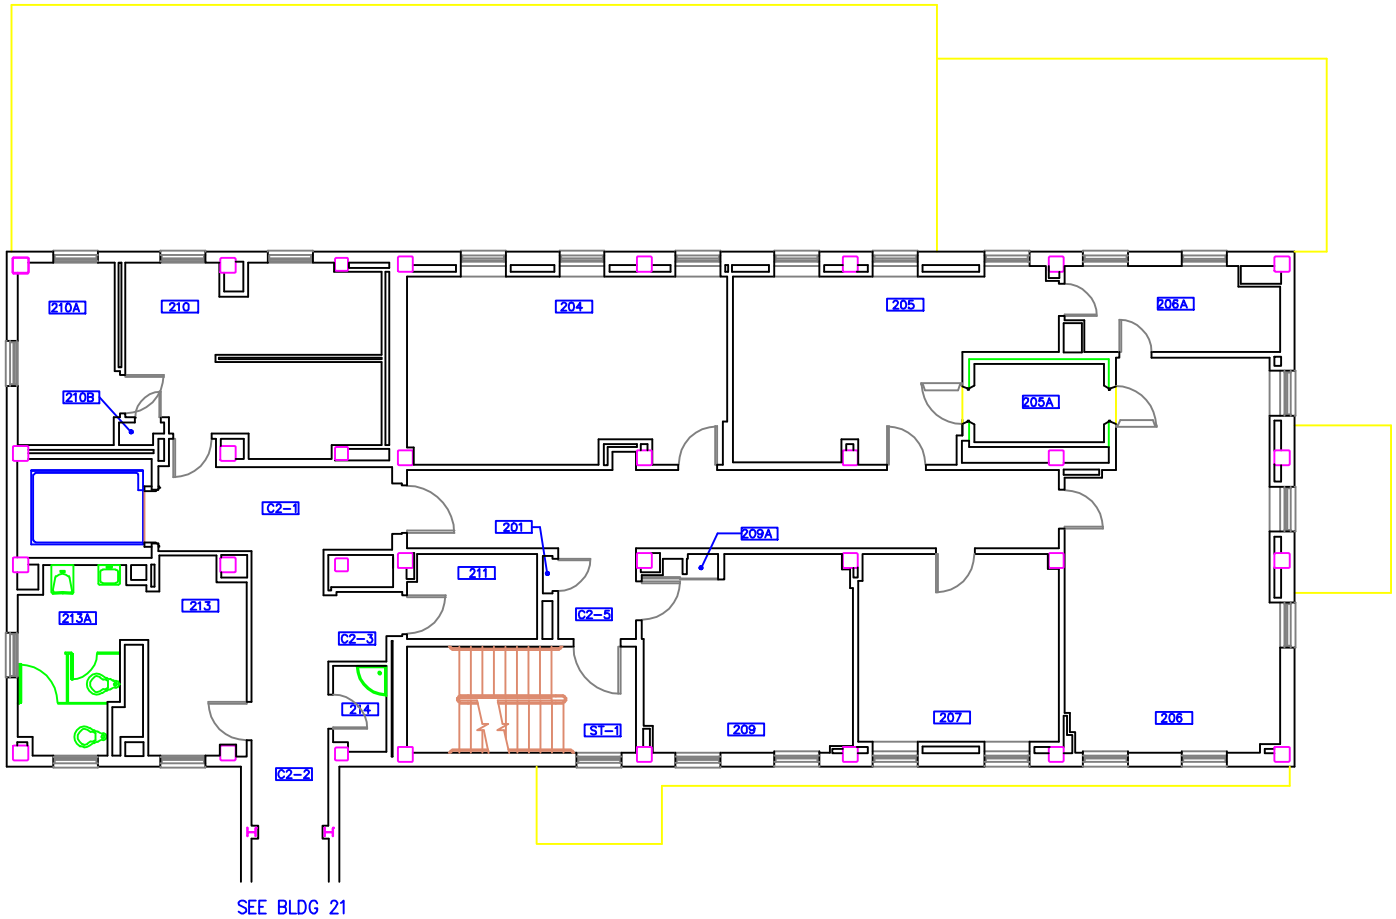

BLDG 19 – 2nd FLOOR

SCALE: 1/4" = 1'-0"

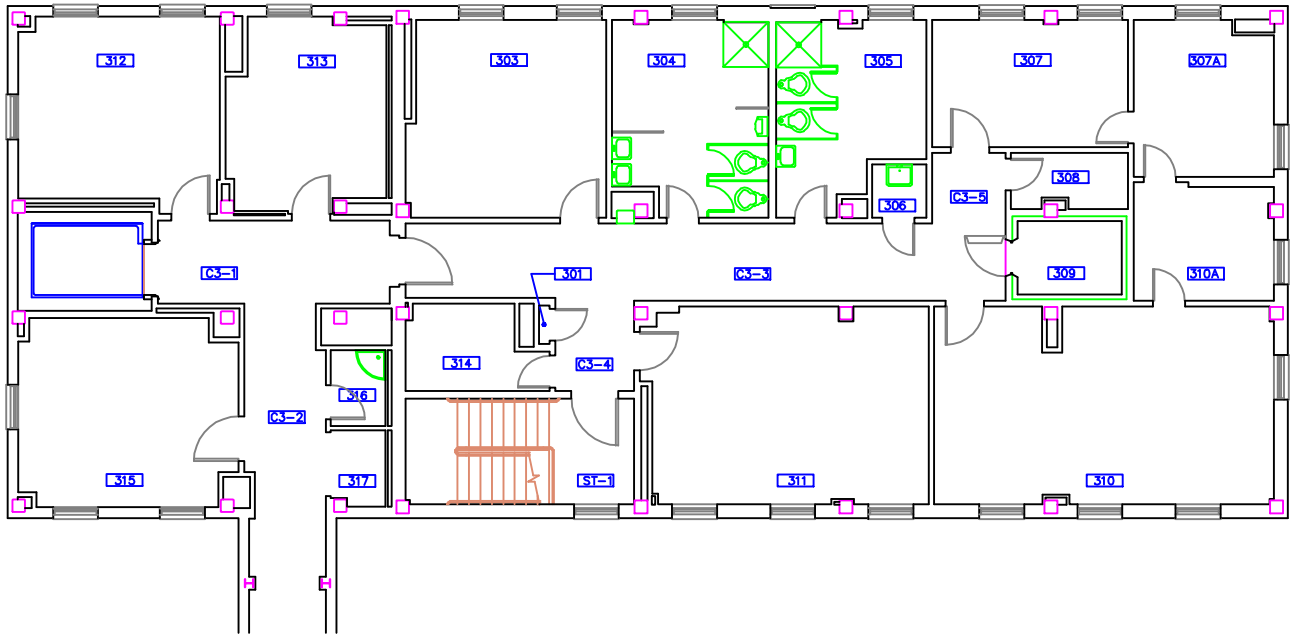

SEE BLDG 21

BLDG 19 – 3rd FLOOR

SCALE: 1/4" = 1'-0"

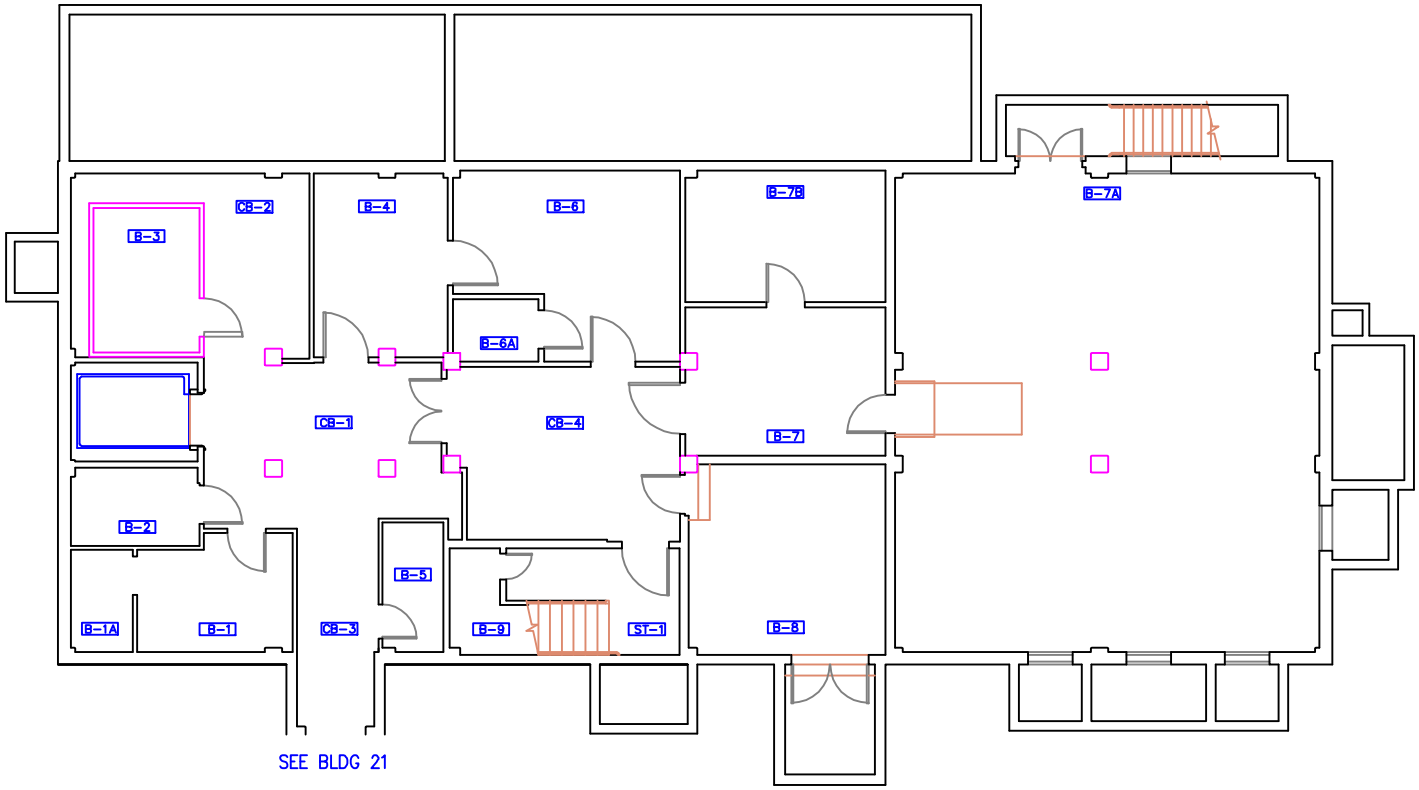

BLDG 19 – BSMT FLOOR

SCALE: 1/4" = 1'-0"

BUILDING 21 Sub-Basement

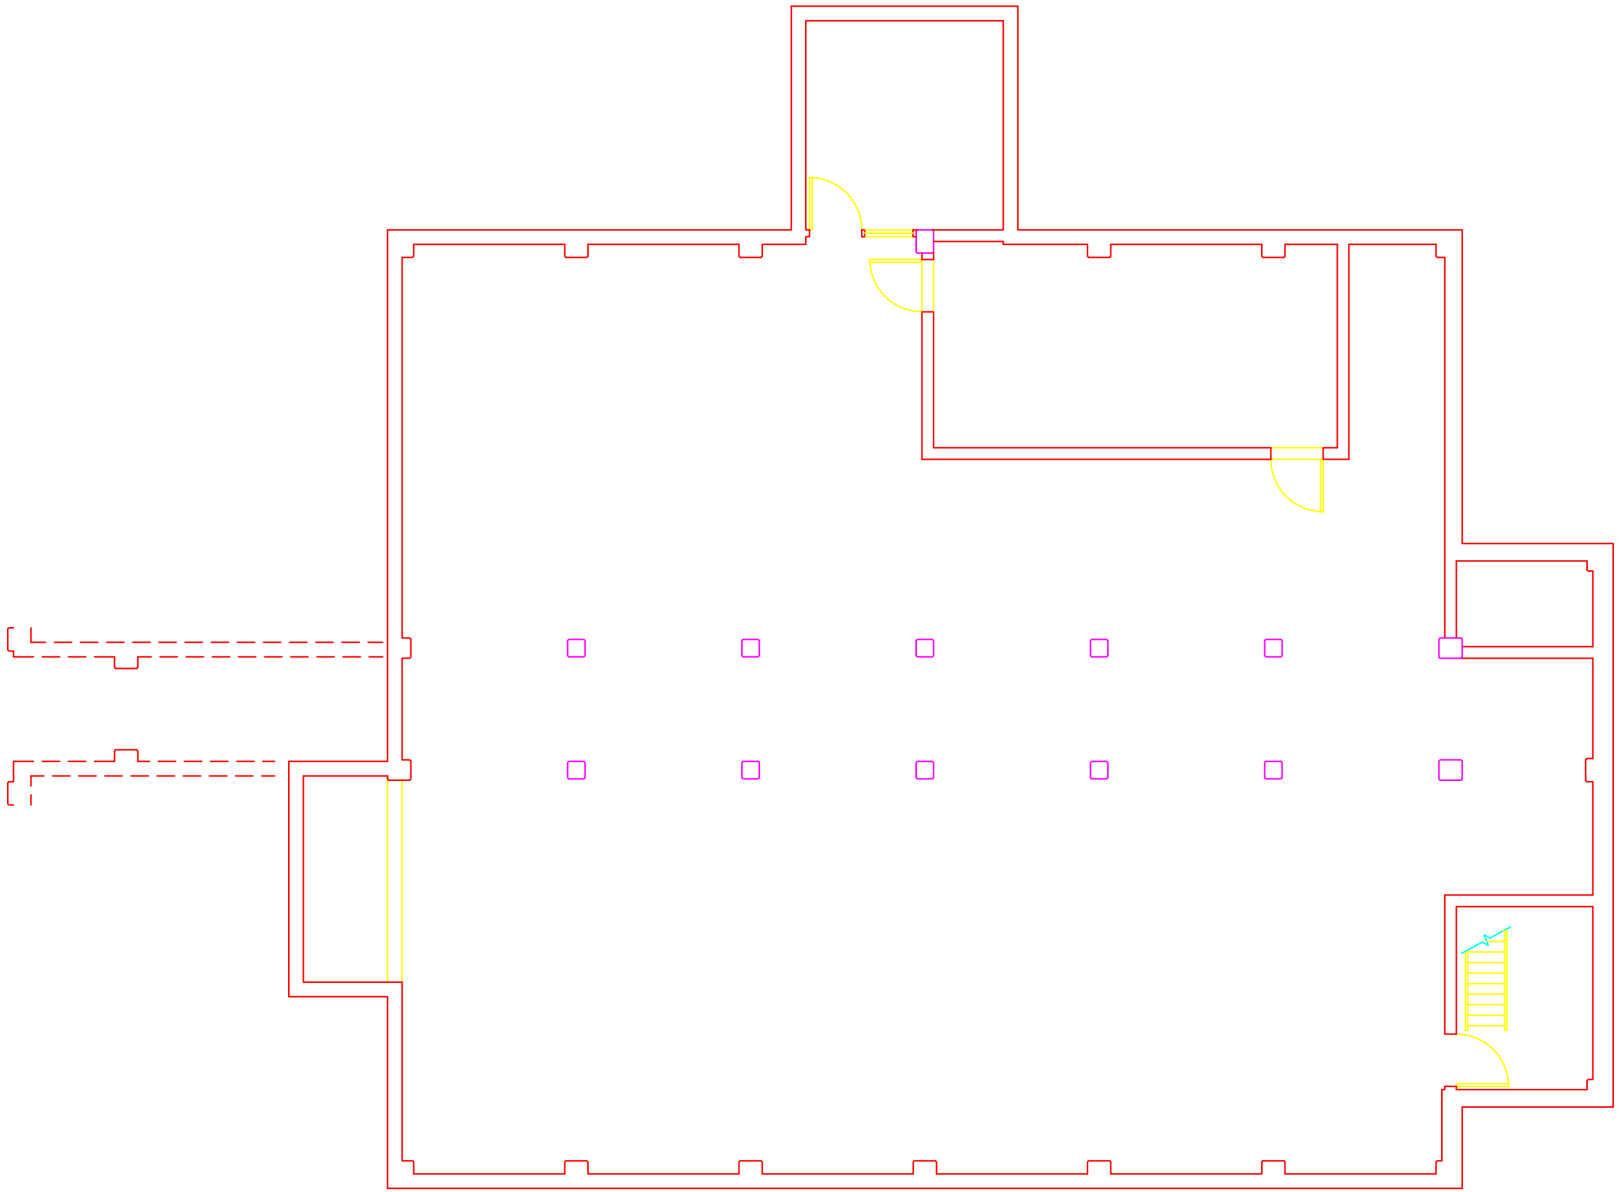

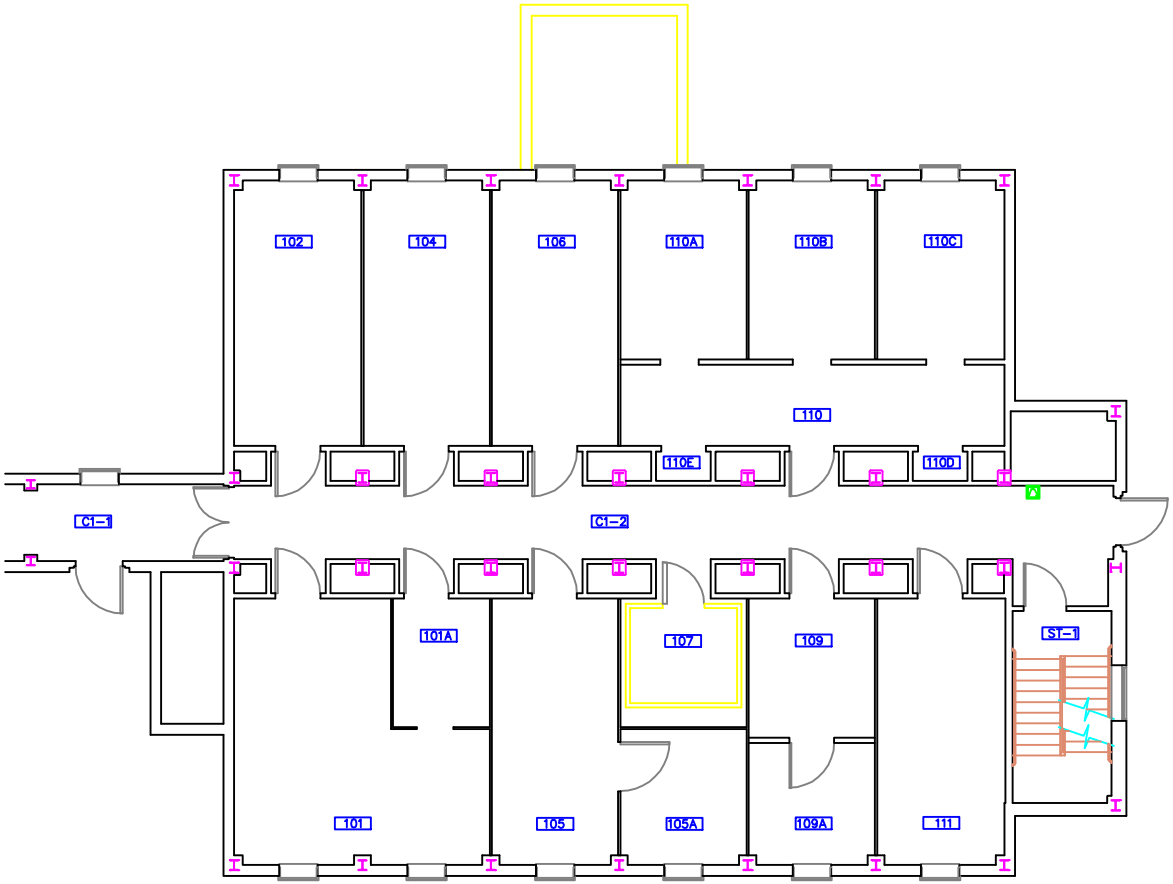

BLDG 21 – 1st FLOOR

SCALE: 1/4" = 1'-0"

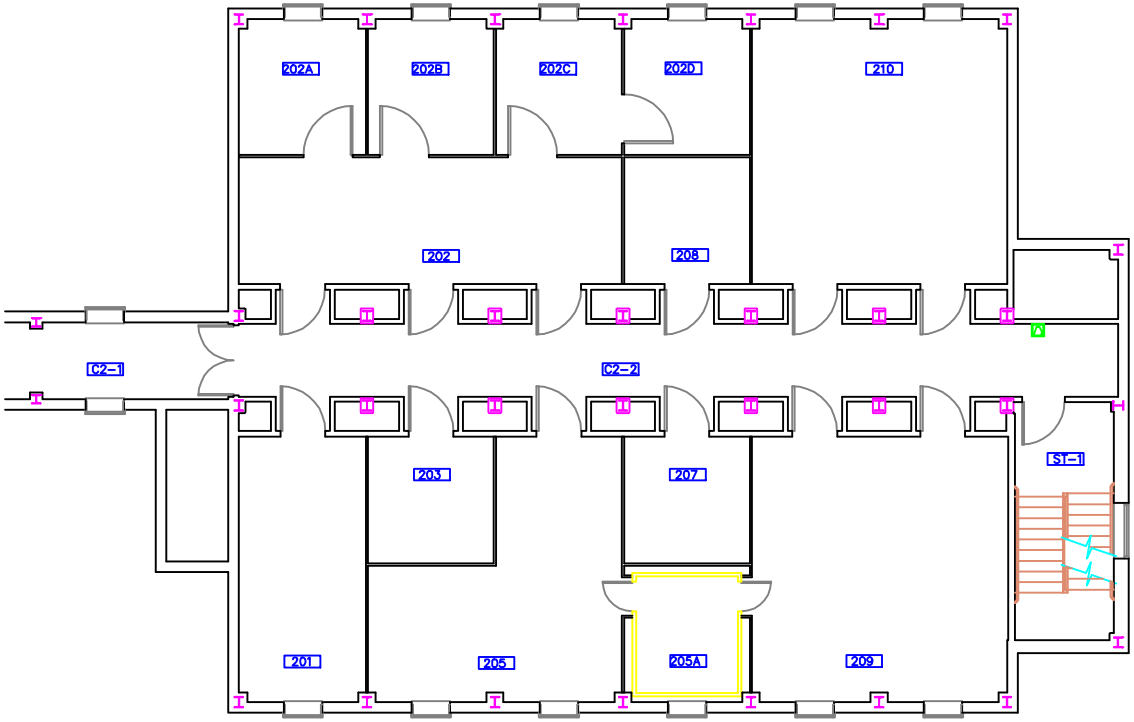

BLDG 21 – 2nd FLOOR

SCALE: 1/4" = 1'-0"

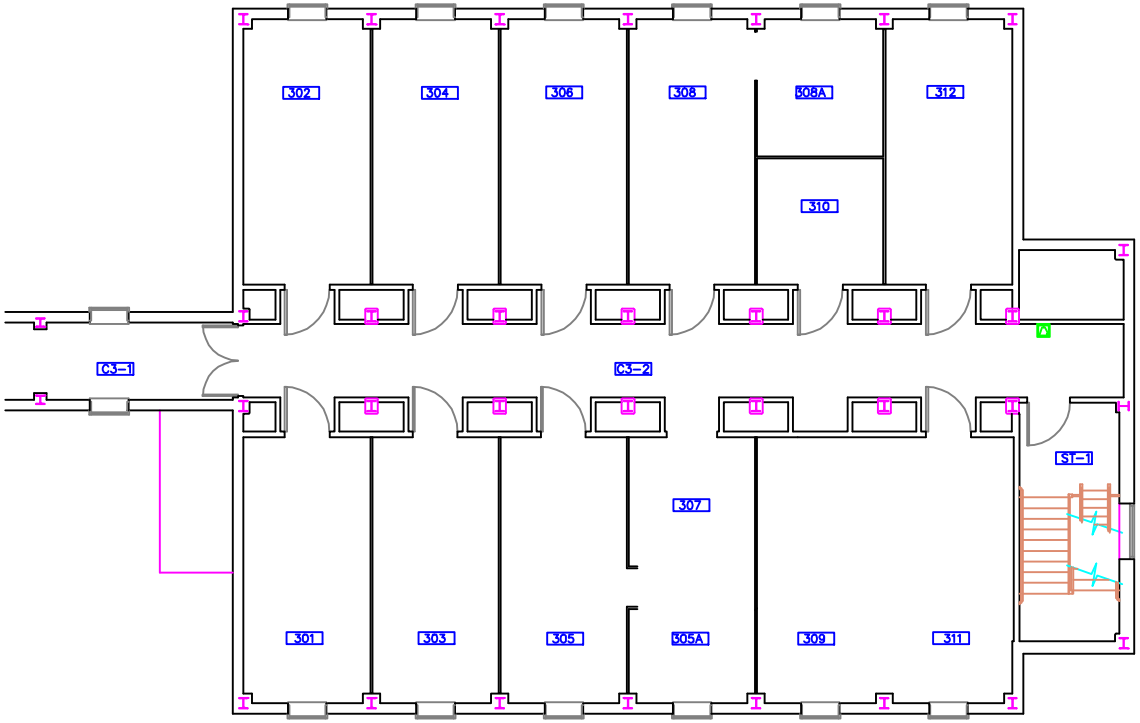

BLDG 21 – 3rd FLOOR

SCALE: 1/4" = 1'-0"

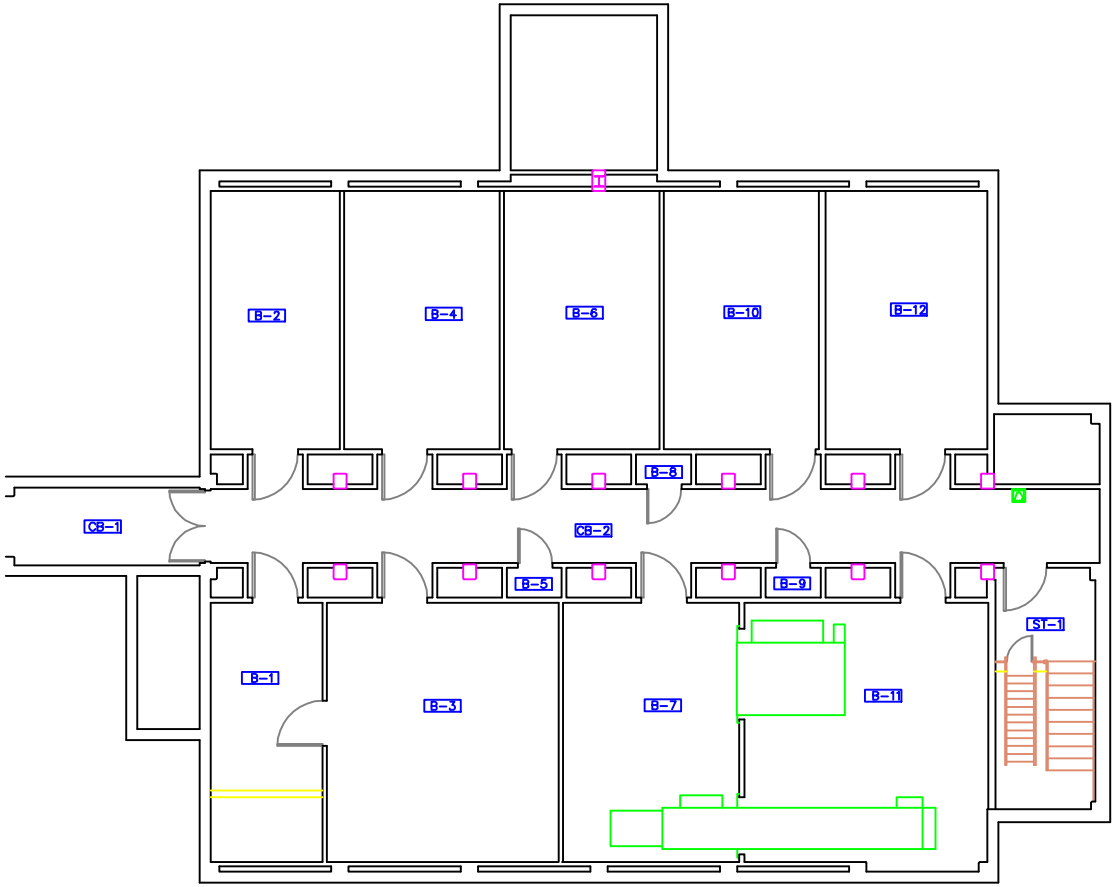

BLDG 21 – BASEMENT

SCALE: 1/4" = 1'-0"

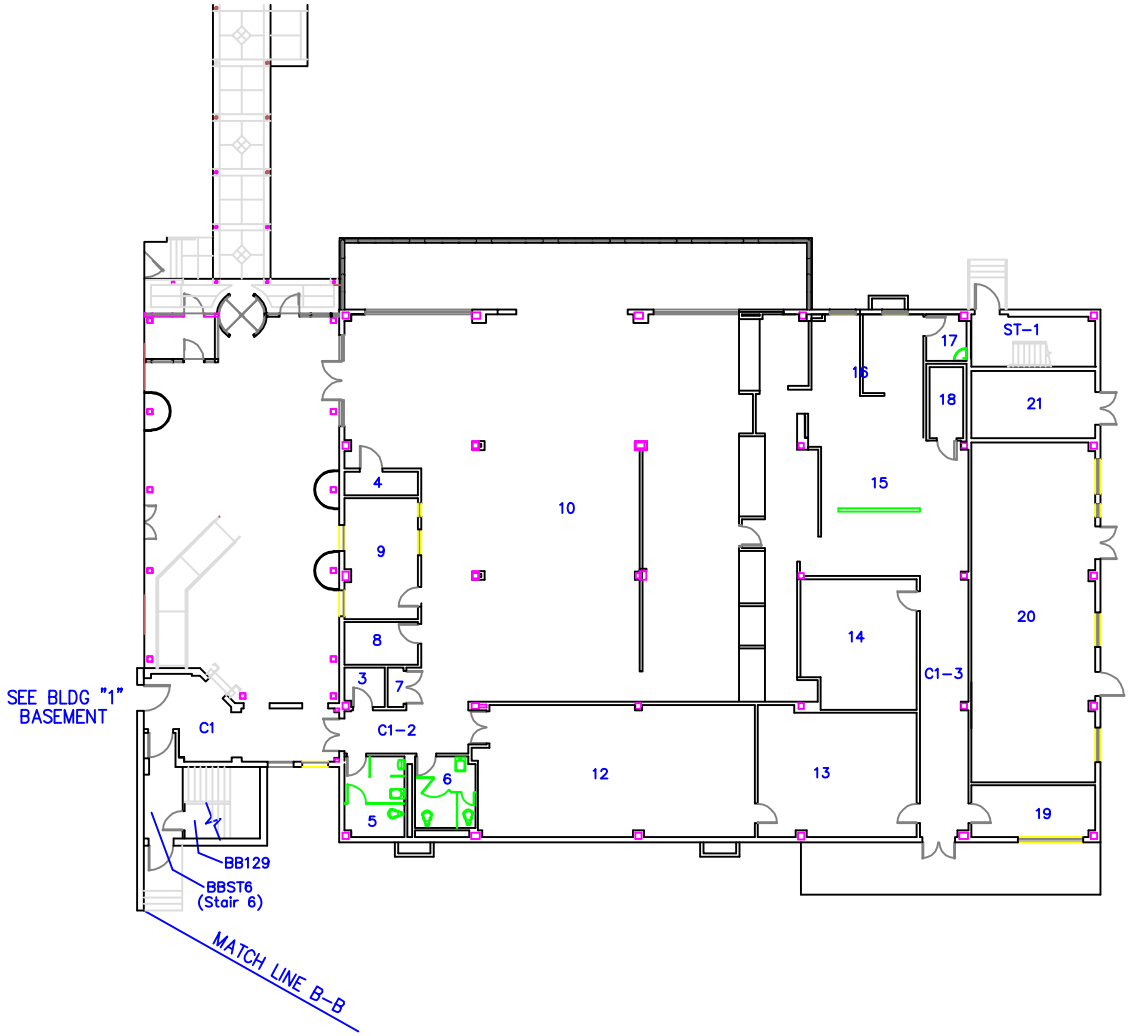

BLDG #24 – 1st FLOOR

SCALE: 1/8" = 1'- 0"

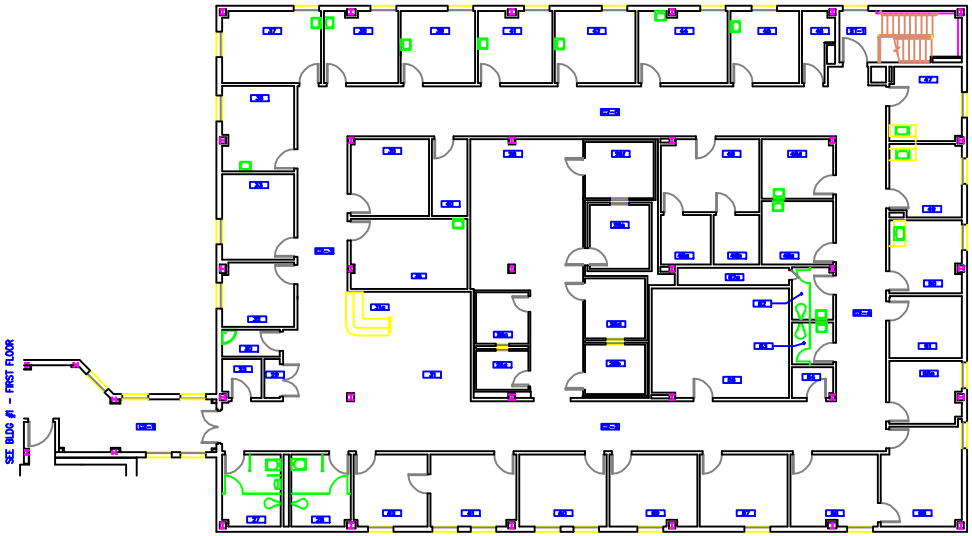

BLDG 24 – 2nd FLOOR

SCALE: 1/4" = 1'-0"